
Agency Index CR-17-193 CORNER RECORD Document Number City of Lodi County of San Joaquin California Brief Legal Description Portion of Lot 2, Block 7, of "Hutchins Addition to City of Lodi" **CORNER TYPE COORDINATES (Optional)** E. Control Government Corner Elevation U.S. Survey Foot X Meander Property Rancho Other Horizontal Datum Zone **Epoch Date** Date of Survey May 31, 2017 Vertical Datum T.3N., R.6E. Complies with Public Resources Code §§8801-8819 M.D.B.&M. Complies with Public Resources Code §§8890-8902 PLS Act Ref.: 8765(d) X 8771 8773 Other: Left as found Established Rebuilt Pre-Construction Corner/ Monument: Found and tagged Reestablished Referenced Post-Construction Narrative of corner identified and monument as found, set, reset, replaced, or removed: See sheet #2 for description(s): It is the purpose of this corner record to establish ties to an existing monument prior to construction. The monument found and tied out was an axle as depicted on attached exhibit. SURVEYOR'S STATEMENT This Corner Record was prepared by me or under my direction in conformance with the Professional Land Surveyors' Act on May 31, 2017 7889 Signed **COUNTY SURVEYOR'S STATEMENT**

This Corner Record was received			June 27, 2017		
and exami	ned and filed	July	14,2017	·	
Signed	Wan D.	In 2	P.L.S. or -R.	C.E. No. 4842	
Title _	County Surve	?yor			
County S	Surveyor's Comment				



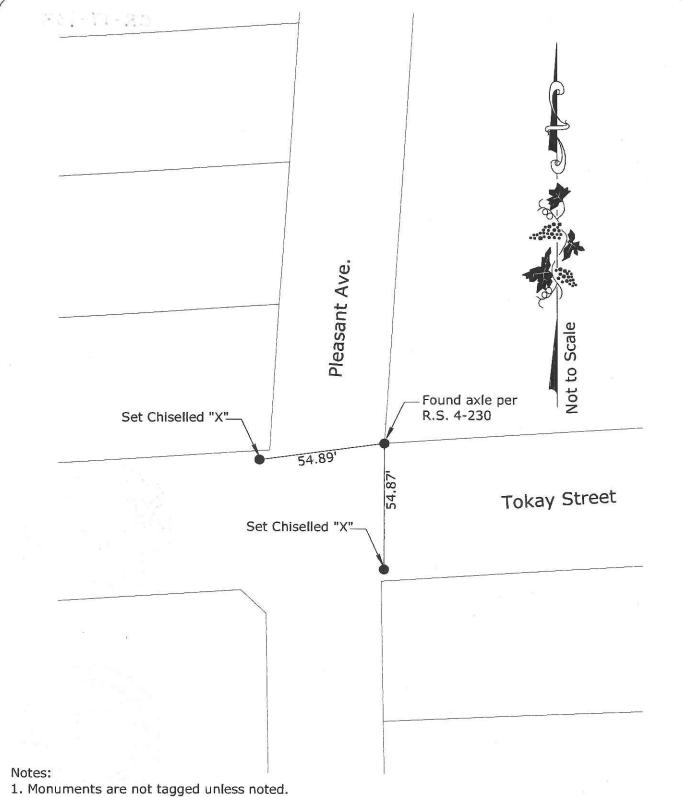

- 2. No attempt was made to verify the monument(s)



PREPARED IN THE OFFICE OF:

BAUMBACH & PIAZZA, INC.

CIVIL ENGINEERS . SURVEYORS

www.bpengineers.net 209.368.6618

323 W. Elm St. Lodi, CA 95240