COF	RNE	RRE	COF	RD	Agency Ind		CR-17	'-231	
					Document			O lit i	
City of Stock		DI 1 (\%)	4 1 1111		County of	β0 -		, California	a
Brief Legal De	escription	Plat of Villa	Addition,	Book of	Maps & PI	ats 2, Pa	ige 6/		_
				R TYPE				ES (Optional) _E	
		Government Co	ner 🗌	Control	X	Elevation			
33	1	Meander		Property		Units	Metric	U.S. Survey Foot X	
		Rancho		Other			Datum		
Rancho Del Campo de Los Franceses	J 	Date of Survey	Februar	ry 22, 2	017	Vertical Dai	tum ies with Public Re	Date 1991.35 sources Code §§8801-880 sources Code §§8890-890	19
PLS Act Ref:	8765(d)	X	8771		8773		По	ther:	
	X Left as for Found a	ound	Established Reestablish	ed	Rebuilt Referenced	1	⊠ Pr	e-Construction ost-Construction	
	Book 35 ige 2.	of Surveys, P SURVEYOR'S ared by me or und	STATEMEN er my directio	idence i	rmance with		JAMES	ontal Control System in more detail LAND SUBJECTION C. BRAINARD OF CALIFORN OF	
This Corner Recor		vedAug	or's stati		2017		SSI	WARREN D SHIP	 8
and examined and Signed	hy Su	August	P.L.S. c	_, <u>Z</u> 0	017 o. 4842		O. T.	WARREN D SMITH NO 4842	
County Survey	or's Comi	ment					40.0	N. S.	

STATEMENT OF PURPOSE:

THE PURPOSE OF THIS SURVEY IS TO IDENTIFY AND RECORD THE LOCATION OF EXISTING MONUMENTS PRIOR TO PG&E IMPROVEMENTS. NO CLAIM IS MADE AS TO THE RELATIONSHIP OF THE MONUMENTS SHOWN HEREON TO THE EXISTING PROPERTY LINES. ORIGINAL LOT LINES SHOWN ARE FOR GENERAL LOCATION AND INFORMATIONAL PURPOSES ONLY.

DATUM STATEMENT:


COORDINATES SHOWN HEREON ARE GRID AND ARE BASED ON CITY OF STOCKTON MONUMENTS 26, 29, 168 AND 172 CALIFORNIA COORDINATE SYSTEM (CCS83), ZONE III, 1983 NAD, (1991.35 EPOCH STOCKTON & SAN JOAQUIN COUNTY GPS ADJUSTMENT) AS SHOWN ON RECORD OF SURVEY BOOK 35 OF SURVEYS, PAGE 05.



GRID COORDINATES (U.S. SURVEY FEET)							
POINT	NORTHING	EASTING	REFERNCE				
26	2172665.18'	6334252.32	35 - RS - 05				
29	2165796.16	6335671.83	35 - RS - 05				
50	2170387.36	6342627.48	NO RECORD				
168	2174916.33'	6343710.29	35 - RS - 05				
172	2169512.63'	6346803.70	35 - RS - 05				

LEGEND:

INDICATES FOUND CITY OF STOCKTON MONUMENT IN MONUMENT BOX, AS DESCRIBED.

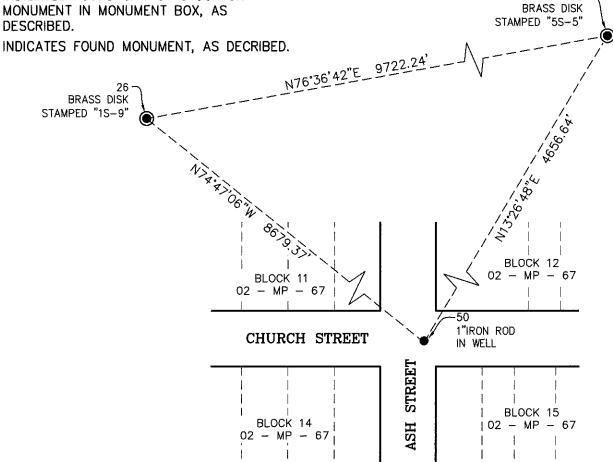

(8665_DISTRIBUTION\195 - L5 & E5 Distribution Support (Stockton)\D4-Monument Preservation\31221648 - Mon Pres - E. Church SL. Stockton\DRAWNC\PL5-CADD\Comer Record\6565.195 Church Comer Record 1.dwg