
## **CORNER RECORD**

				Docume	nt Number	CK-11-2	6/
City ofTracy	1			County	of San Joac	uin	, California
Brief Legal Des	scription _	Lot 11 per M. & P.	27-86, S.J	.C.R.			
		CO	RNER TYP	E		COORDINATES(C	optional)
X		Government Corner Meander Rancho	Co	ontrol	E Zone	NAD2	7 NAD83
c. 3 T.3S., R.5E M.D.B. & M.	71	Date of Survey M	arch 24, 20	016	Vert. Datun Meas. Units		NADV88 Imperial
Corner -	_eft as found	<b>▼</b> Found an	nd tagged	Established	Red	established	Rebuilt
A description of th See Sheet 2	e physical c	ondition of the monur	nent as four	nd and as set or re	eset:		
This Corner Rec		SURVEYOR'S Separed by me or un	nder my dir		nance with	No. 44	Water State of State
Signed	02.0			E. No.: _L.S	. 4450	STATE OF CAL	FORMULA
		COUNTY SURVEYO	NOT THE DESCRIPTION			MALL	AND
	Septem M Surve	yor you	1017	e .	and examine	WARR SMI	e-   3
			11 11 11 11				

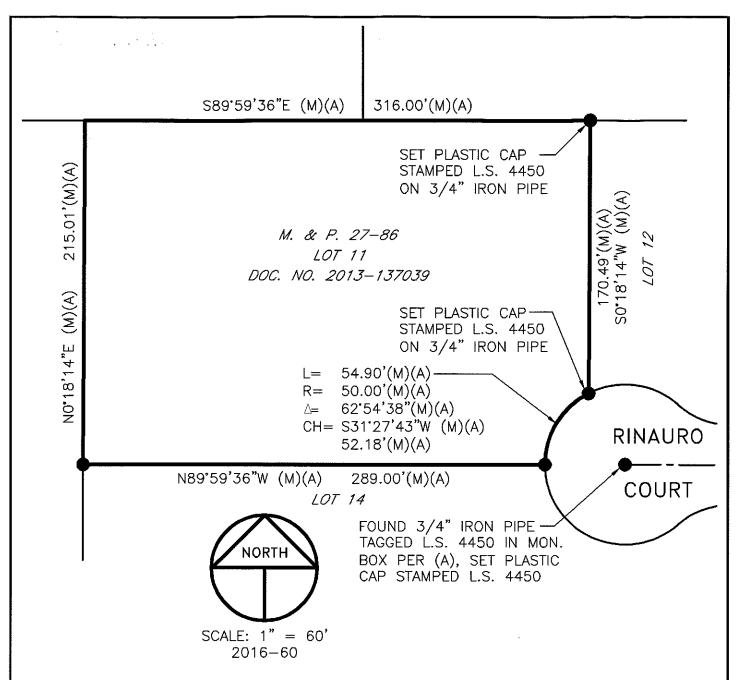

## **LEGEND**

INDICATES FOUND 3/4" IRON PIPE TAGGED L.S. 4450 PER (A), UNLESS OTHERWISE NOTED.

(M) INDICATES MEASURED ON THIS SURVEY

M. & P. INDICATES MAPS AND PLATS, VOLUME AND PAGE, S.J.C.R.

S.J.C.R. INDICATES SAN JOAQUIN COUNTY RECORDS

## <u>REFERENCE</u>

(A) M. & P. 27-86, S.J.C.R.