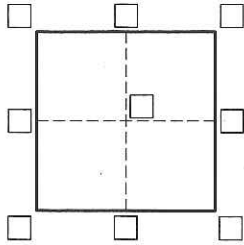


CORNER RECORD

Agency Index CR-17-271

Document Number _____

City of LATHROP County of SAN JOAQUIN, CaliforniaBrief Legal Description LOTS 1-5, BLOCK 15, VOL. 25, MAPS AND PLATS, PG. 26**CORNER TYPE**

Government Corner Control
 Meander Property
 Rancho Other

Date of Survey JUNE 5, 2017**COORDINATES (Optional)**

N. _____ E. _____

Elevation _____

Units Metric U.S. Survey Foot

Horizontal Datum _____

Zone _____ Epoch Date _____

Vertical Datum _____

 Complies with Public Resources Code §§8801-8819 Complies with Public Resources Code §§88900-8902PLS Act Ref.: 8765(d) 8771 8773 Other:Corner/Monument: Left as found Established Rebuilt Pre-Construction Found and tagged Reestablished Referenced Post-Construction

Narrative of corner identified and monument as found, set, reset, replaced, or removed:

 See sheet #2 for description(s):

FOUND (1) 1" IRON REBAR AS SHOWN ON VOL. 25, MAPS & PLATS, PG. 26

FOUND (1) 3/4" IRON PIPE AS SHOWN ON VOL. 25, MAPS & PLATS, PG. 26


FOUND (1) 3/4" IRON PIPE W/ PLUG IN SAME POSITION AS SHOWN ON 32 SURVEYS 149

SET (4) 3/4" IRON PIPES W/ PLASTIC PLUG & TACK, TAGGED "LS7539"

SURVEYOR'S STATEMENT

This Corner Record was prepared by me or under my direction in conformance with

the Professional Land Surveyor's Act on August 23, 2017Signed [Signature] P.L.S. or R.C.E. No. LS 7539**COUNTY SURVEYOR'S STATEMENT**This Corner Record was received August 25, 2017and examined and filed September 8, 2017Signed Warren D. Smith P.L.S. or R.C.E. No. 4842Title County Surveyor**County Surveyor's Comment:**

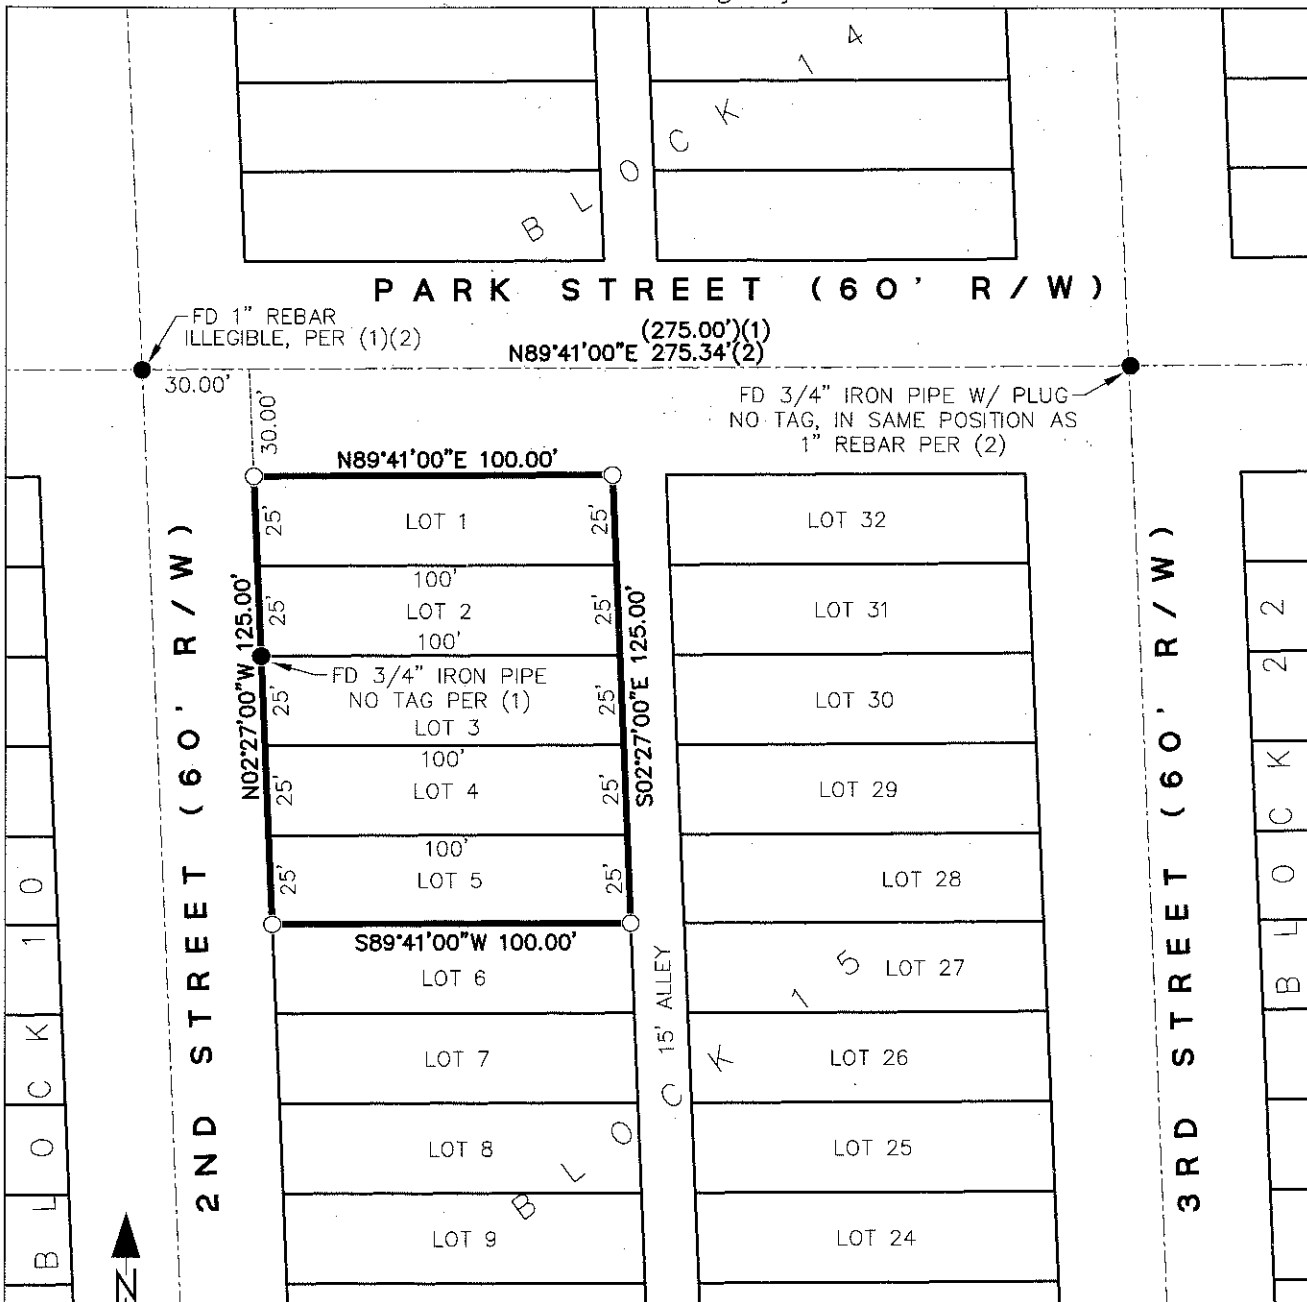

PARK STREET (60' R/W)


FD 1" REBAR ILLEGIBLE, PER (1)(2) (275.00')(1) N89°41'00"E 275.34'(2)

FD 3/4" IRON PIPE W/ PLUG NO TAG, IN SAME POSITION AS 1" REBAR PER (2)

N89°41'00"E 100.00'
 LOT 1
 100'
 LOT 2
 100'
 FD 3/4" IRON PIPE NO TAG PER (1)
 LOT 3
 100'
 LOT 4
 100'
 LOT 5
 100'
 S89°41'00"W 100.00'
 LOT 6
 LOT 7
 LOT 8
 LOT 9

LOT 32
 LOT 31
 LOT 30
 LOT 29
 LOT 28
 LOT 27
 LOT 26
 LOT 25
 LOT 24

AMENDING MAP OF SOUTHERN PACIFIC ADDITION TO LATHROP VOL. 25 MAPS AND PLATS, PAGE 26

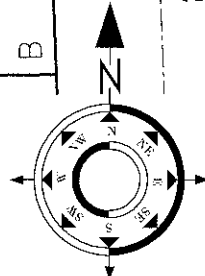

SCALE: 1"=50'

NOTE
 ALL BEARINGS AND DISTANCES ARE RECORD DATA PER 25 M&P 26 UNLESS OTHERWISE NOTED.

LEGEND

- (1) INDICATES RECORD REFERENCE TO 25 M&P 26
- (2) INDICATES RECORD REFERENCE TO 32 SURVEYS 149
- M&P MAPS & PLATS
- R/W RIGHT-OF-WAY
- FOUND PIPE OR REBAR AS NOTED
- SET 3/4" IRON PIPE, WITH PLASTIC PLUG & TACK, TAGGED "LS7539"
- SUBJECT LOT LINE
- ADJOINING LOT LINE
- - - - - CENTERLINE

JOB NO. 5064-01