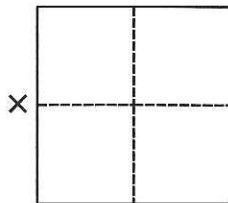


# CORNER RECORD

Agency Index CR-17-291

Document Number \_\_\_\_\_

City of Manteca County of San Joaquin, CaliforniaBrief Legal Description West 1/4 corner for Section 16, Township 2 South, Range 7 East, M.D.B.M.**CORNER TYPE****COORDINATES (Optional)**

Government Corner  Control   
 Meander  Property   
 Rancho  Other

N. \_\_\_\_\_ E. \_\_\_\_\_

Elevation \_\_\_\_\_

Units Metric  U.S. Survey Foot 

Horizontal Datum \_\_\_\_\_

Zone \_\_\_\_\_ Epoch Date \_\_\_\_\_

Date of Survey July 10, 2017


Vertical Datum \_\_\_\_\_

 Complies with Public Resources Code §§8801-8819 Complies with Public Resources Code §§8890-8902PLS Act Ref.:  8765(d)  8771  8773  Other:Corner/Monument:  Left as found  Established  Rebuilt  Pre-Construction Found and tagged  Reestablished  Referenced  Post-Construction

Narrative of corner identified and monument as found, set, reset, replaced, or removed:

 See sheet #2 for description(s):**SURVEYOR'S STATEMENT**

This Corner Record was prepared by me or under my direction in conformance with

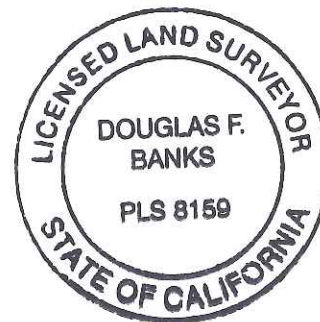the Professional Land Surveyors' Act on August 31, 2017.Signed Douglas F. Banks P.L.S. or R.C.E. No. PLS 8159**COUNTY SURVEYOR'S STATEMENT**This Corner Record was received September 22, 2017and examined and filed October 6, 2017.Signed Warren D. Smith P.L.S. or R.C.E. No. 4842Title County Surveyor**County Surveyor's Comment**

