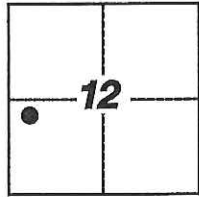


CORNER RECORD

Agency Index: CR-17-295

Document Number: _____

City of LODICounty of SAN JOAQUIN, CaliforniaBrief Legal Description FOUND MONUMENTS ALONG THE EAST & WEST RIGHT-OF-WAY LINE OF SOUTH LEE AVENUE; NO REFERENCE.

T.3N, R.6E

CORNER TYPE

- | | |
|--|--|
| <input type="checkbox"/> Government Corner | <input type="checkbox"/> Control |
| <input type="checkbox"/> Meander | <input checked="" type="checkbox"/> Property |
| <input type="checkbox"/> Rancho | <input type="checkbox"/> Other |

Date of Survey 7-12-2017**COORDINATES (Optional)**

N. _____ E. _____

Elevation _____

Units ☐ Metric ☒ U.S. Survey Foot

Horizontal Datum _____

Zone _____ Epoch Date _____

Vertical Datum _____


☐ Complies with Public Resources Code §§8801-8819☐ Complies with Public Resources Code §§8890-8902PLS Act Ref: ☐ 8765(d) ☒ 8771 ☐ 8773 ☐ Other: _____

Corner/ Monument:	<input checked="" type="checkbox"/> Left as found	<input type="checkbox"/> Established	<input type="checkbox"/> Rebuilt	<input checked="" type="checkbox"/> Pre-Construction
	<input type="checkbox"/> Found and Tagged	<input type="checkbox"/> Reestablished	<input type="checkbox"/> Referenced	<input type="checkbox"/> Post-Construction

Narrative of corner identified and monument as found, set, reset, replaced, or removed:

☒ See sheet #2 for description(s):FOUND MONUMENTS, NO REFERENCE; SET THREE (3) CONCRETE NAILS WITH BRASS TAG STAMPED"LS 6953" AS WITNESS CORNERS, ALL AS SHOWN ON SHEET 2**SURVEYOR'S STATEMENT**This Corner Record was prepared by me or under my direction in conformance with
the Land Surveyors' Act on JULY 21, 2017,Signed [Signature] P.L.S. or ~~R.C.E.~~ Number 6953**COUNTY SURVEYOR'S STATEMENT**This Corner Record was received September 14, 2017and examined and filed October 9, 2017Signed [Signature] P.L.S. or ~~R.C.E.~~ No: 4842Title County Surveyor

County Surveyor's Comment _____

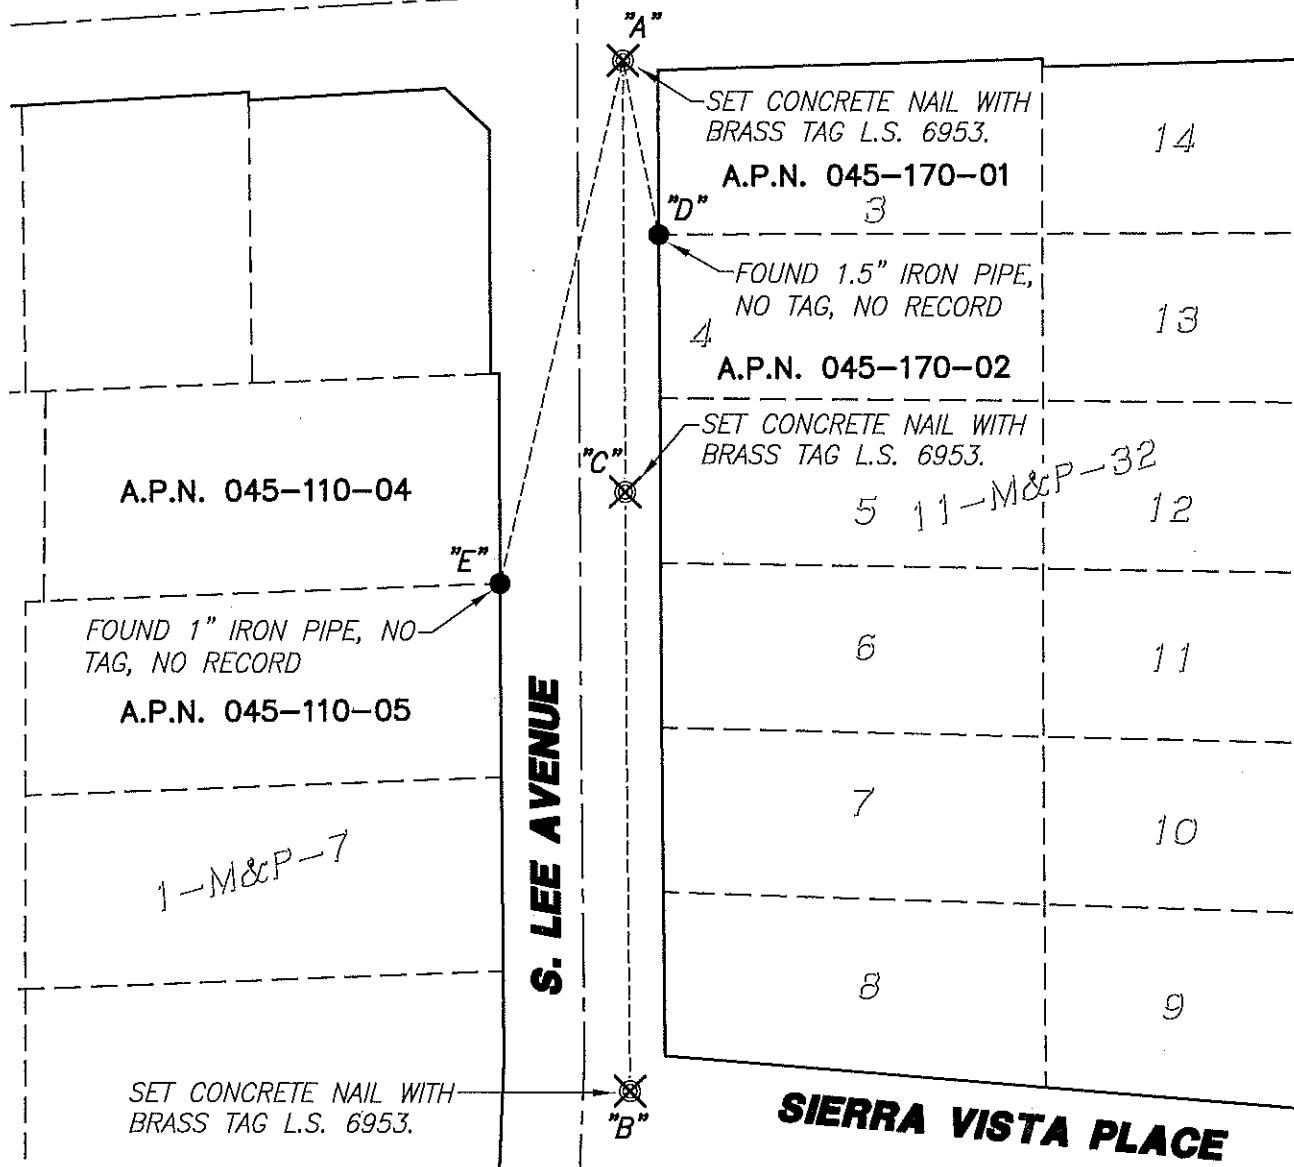W. VINE STREET

NOT TO SCALE

LEGEND:

SET MONUMENT AS NOTED.



FOUND MONUMENT AS NOTED.

M&P MAPS & PLATS

S.J.C.R. SAN JOAQUIN COUNTY RECORDS

(M) MEASURED DISTANCE. ALL DISTANCES ARE
MEASURED UNLESS NOTED OTHERWISE.

X AND DISTANCE TABLE		
BS-@-FS	X	FS DISTANCE
B-A-B	00°00'00"	351.42'(M)
B-A-C	00°00'00"	156.84'(M)
B-A-D	342°44'58"	52.94'(M)
B-A-E	12°10'20"	160.62'(M)

NOTE:THIS CORNER RECORD DOES NOT
VERIFY THIS MONUMENT TO BE
IN THE CORRECT POSITION.