

CORNER RECORD

Agency Index: CR-17-302

Document Number: _____

City of LODI

County of SAN JOAQUIN, California

Brief Legal Description FOUND MONUMENT ALONG THE EAST RIGHT-OF-WAY LINE OF PLEASANT AVENUE, AS SHOWN IN VOLUME 11 OF MAPS & PLATS, PAGE 29, S.J.C.R.



T.3N, R.6E

CORNER TYPE

- Government Corner
- Meander
- Rancho
- Control
- Property
- Other

Date of Survey 7-12-2017

COORDINATES (Optional)

- N. _____ E. _____
- Elevation _____
- Units Metric U.S. Survey Foot
- Horizontal Datum _____
- Zone _____ Epoch Date _____
- Vertical Datum _____
- Complies with Public Resources Code §§8801-8819
- Complies with Public Resources Code §§8890-8902

- PLS Act Ref: 8765(d) 8771 8773 Other: _____
- Corner/Monument: Left as found Established Rebuilt Pre-Construction
 Found and Tagged Reestablished Referenced Post-Construction

Narrative of corner identified and monument as found, set, reset, replaced, or removed:

See sheet #2 for description(s):

FOUND MONUMENT PER 11-M&P-29; SET THREE (3) CONCRETE NAILS WITH BRASS TAG STAMPED
"LS 6953" AS WITNESS CORNERS, ALL AS SHOWN ON SHEET 2

SURVEYOR'S STATEMENT

This Corner Record was prepared by me or under my direction in conformance with the Land Surveyors' Act on JULY 21, 2017,



Signed [Signature] P.L.S. or R.C.E. Number 6953

COUNTY SURVEYOR'S STATEMENT

This Corner Record was received September 14, 2017


and examined and filed October 9, 2017

Signed Warren D. Smith P.L.S. or R.C.E. No: 4842

Title County Surveyor



County Surveyor's Comment _____

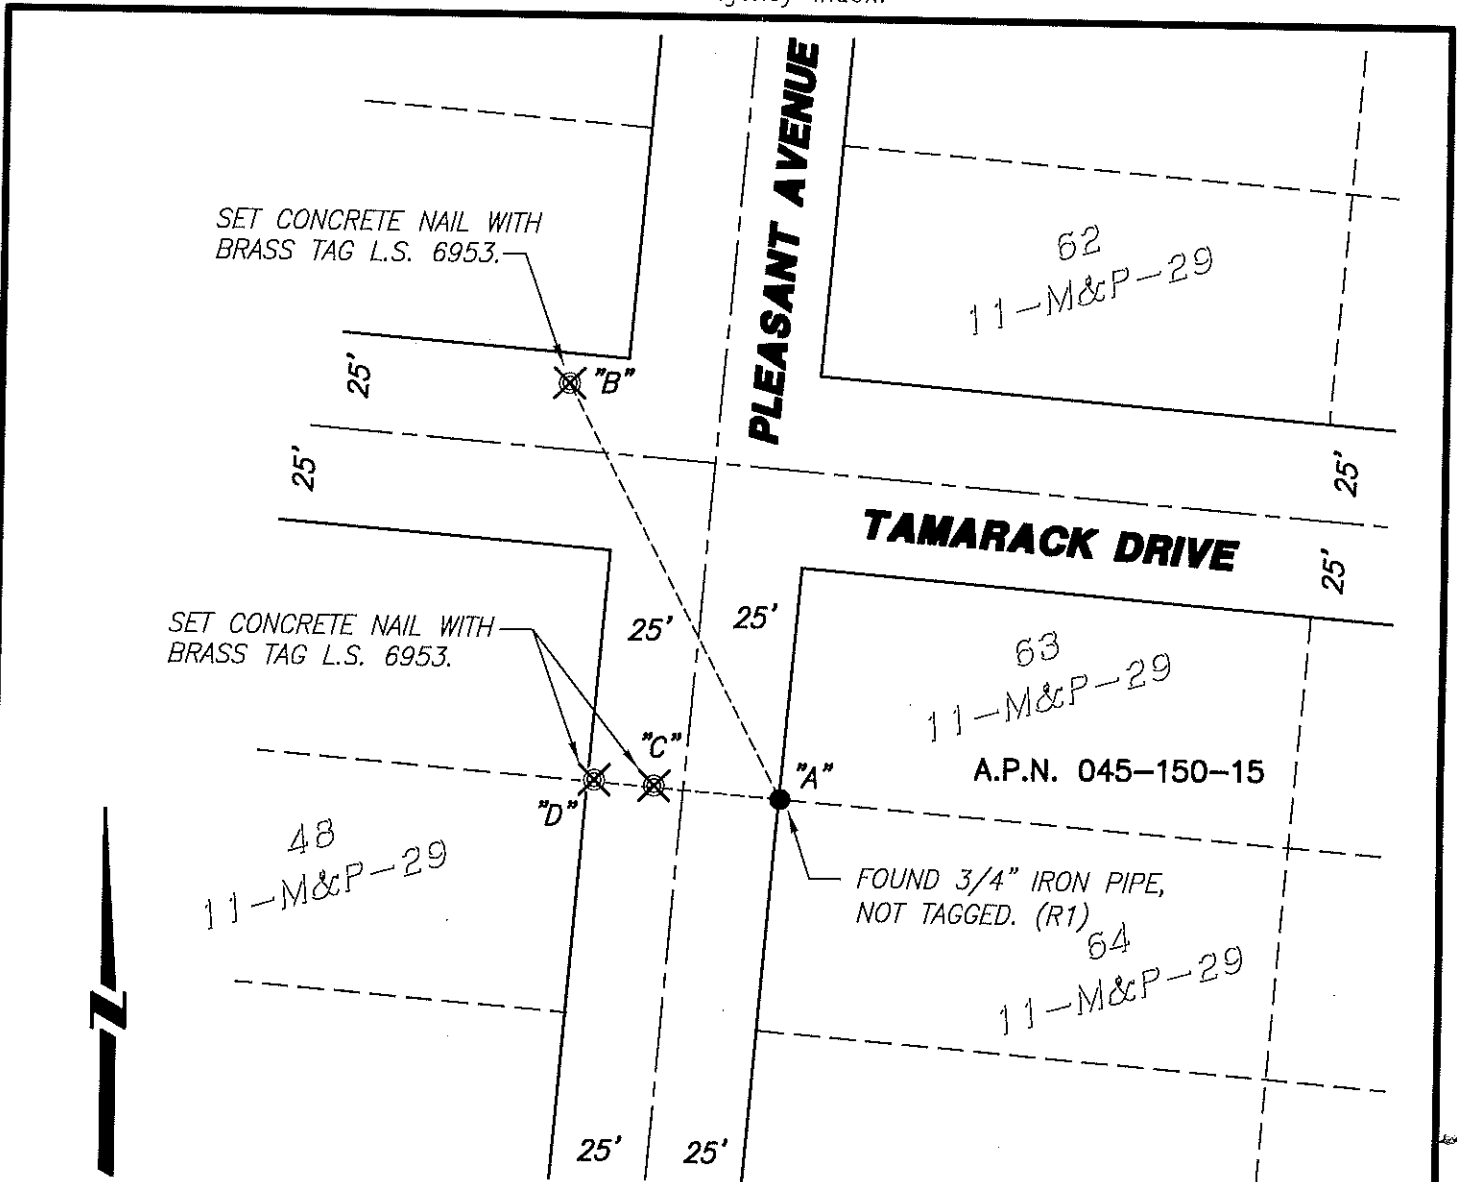

NOT TO SCALE

LEGEND:

- ⊗ SET MONUMENT AS NOTED.
- FOUND MONUMENT AS NOTED.
- M&P- MAPS & PLATS
- S.J.C.R. SAN JOAQUIN COUNTY RECORDS
- (M) MEASURED DISTANCE. ALL DISTANCES ARE MEASURED UNLESS NOTED OTHERWISE.

BS-@-FS	⊗	FS DISTANCE
B-A-B	00'00'00"	140.08'(M)
B-A-C	317'04'29"	59.83'(M)
B-A-D	317'04'29"	85.48'(M)

REFERENCE:

(R1) 11-M&P-29 S.J.C.R.

NOTE:

THIS CORNER RECORD DOES NOT VERIFY THIS MONUMENT TO BE IN THE CORRECT POSITION.