

# CORNER RECORD


Agency Index: CR-17-303

Document Number: \_\_\_\_\_

City of LODI

County of SAN JOAQUIN, California

Brief Legal Description FOUND MONUMENT ALONG THE WEST RIGHT-OF-WAY LINE OF CHURCH STREET,  
NO REFERENCE

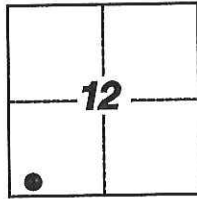

T.3N, R.6E

### CORNER TYPE

- Government Corner     Control  
 Meander                     Property  
 Rancho                         Other

Date of Survey 7-12-2017

### COORDINATES (Optional)

- N. \_\_\_\_\_ E. \_\_\_\_\_  
 Elevation \_\_\_\_\_  
 Units     Metric     U.S. Survey Foot  
 Horizontal Datum \_\_\_\_\_  
 Zone \_\_\_\_\_ Epoch Date \_\_\_\_\_  
 Vertical Datum \_\_\_\_\_  
 Complies with Public Resources Code §§8801-8819  
 Complies with Public Resources Code §§8890-8902

PLS Act Ref:     8765(d)                     8771                     8773                     Other:

Corner/  
Monument:     Left as found                     Established                     Rebuilt                     Pre-Construction  
 Found and Tagged                     Reestablished                     Referenced                     Post-Construction

Narrative of corner identified and monument as found, set, reset, replaced, or removed:

See sheet #2 for description(s):

FOUND MONUMENT; SET THREE (3) CONCRETE NAILS WITH BRASS TAG STAMPED "LS 6953" AS WITNESS  
CORNERS, ALL AS SHOWN ON SHEET 2

### SURVEYOR'S STATEMENT

This Corner Record was prepared by me or under my direction in conformance with  
the Land Surveyors' Act on JULY 21, 2017,



Signed [Signature] P.L.S. or R.C.E. Number 6953

### COUNTY SURVEYOR'S STATEMENT


This Corner Record was received September 14, 2017  
and examined and filed October 9, 2017

Signed [Signature] P.L.S. or R.C.E. No: 4842

Title County Surveyor



County Surveyor's Comment \_\_\_\_\_  
\_\_\_\_\_  
\_\_\_\_\_

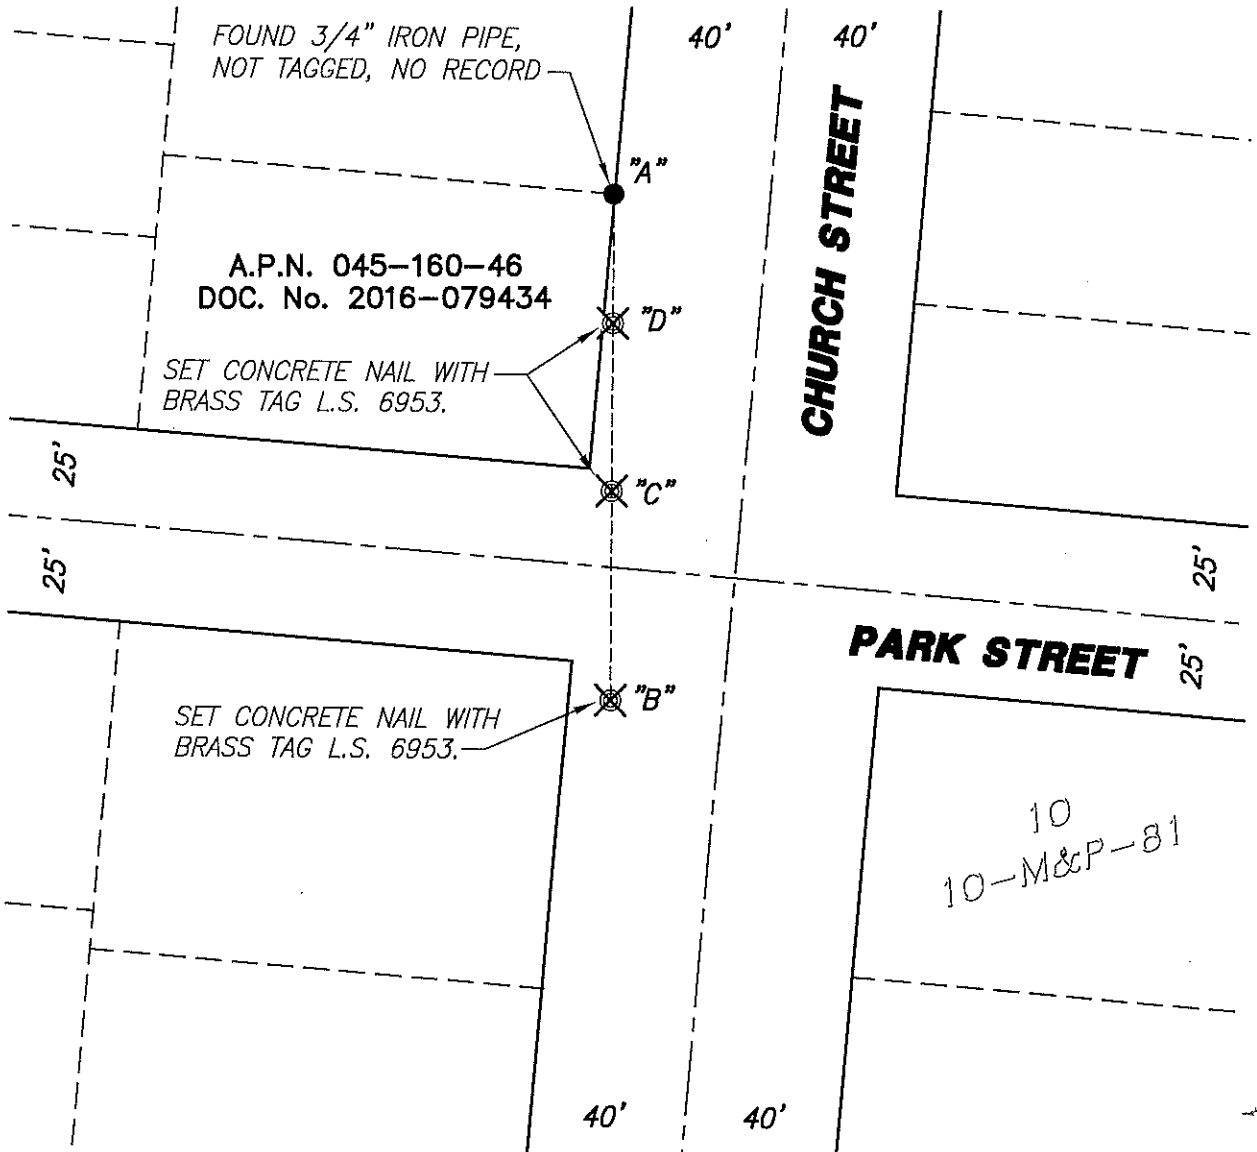

NOT TO SCALE

**LEGEND:**

- ⊗ SET MONUMENT AS NOTED.
- FOUND MONUMENT AS NOTED.
- M&P- MAPS & PLATS
- S.J.C.R. SAN JOAQUIN COUNTY RECORDS
- (M) MEASURED DISTANCE. ALL DISTANCES ARE MEASURED UNLESS NOTED OTHERWISE.

⊗ AND DISTANCE TABLE		
BS-@-FS	⊗	FS DISTANCE
B-A-B	00°00'00"	130.18'(M)
B-A-C	00°00'00"	70.72'(M)
B-A-D	00°00'00"	19.72'(M)

**NOTE:**

THIS CORNER RECORD DOES NOT VERIFY THIS MONUMENT TO BE IN THE CORRECT POSITION.