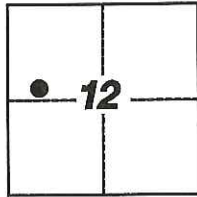


# CORNER RECORD

Agency Index: CR-17-304

Document Number: \_\_\_\_\_

City of LODICounty of SAN JOAQUIN, CaliforniaBrief Legal Description FOUND MONUMENT ALONG THE EAST RIGHT-OF-WAY LINE OF CHURCH STREET, AS SHOWN IN VOLUME 7 OF SURVEYS, AT PAGE 197, S.J.C.R.

T.3N, R.6E

**CORNER TYPE**

- Government Corner     Control  
 Meander                     Property  
 Rancho                          Other

Date of Survey 7-12-2017**COORDINATES (Optional)**

N. \_\_\_\_\_ E. \_\_\_\_\_

Elevation \_\_\_\_\_

Units  Metric  U.S. Survey Foot

Horizontal Datum \_\_\_\_\_

Zone \_\_\_\_\_ Epoch Date \_\_\_\_\_


Vertical Datum \_\_\_\_\_

 Complies with Public Resources Code §§8801-8819 Complies with Public Resources Code §§8890-8902PLS Act Ref:  8765(d)     8771     8773     Other:
 Corner/  
 Monument:  Left as found     Established     Rebuilt     Pre-Construction  
 Found and Tagged     Reestablished     Referenced     Post-Construction

Narrative of corner identified and monument as found, set, reset, replaced, or removed:

 See sheet #2 for description(s):FOUND MONUMENT PER 7-R.S.-197; SET THREE (3) CONCRETE NAILS WITH BRASS TAG STAMPED"LS 6953" AS WITNESS CORNERS, ALL AS SHOWN ON SHEET 2**SURVEYOR'S STATEMENT**This Corner Record was prepared by me or under my direction in conformance with the Land Surveyors' Act on JULY 21, 2017,Signed [Signature] P.L.S. or ~~R.C.E.~~ Number 6953**COUNTY SURVEYOR'S STATEMENT**This Corner Record was received September 14, 2017and examined and filed October 9, 2017Signed [Signature] P.L.S. or ~~R.C.E.~~ No: 4842Title County Surveyor

County Surveyor's Comment \_\_\_\_\_

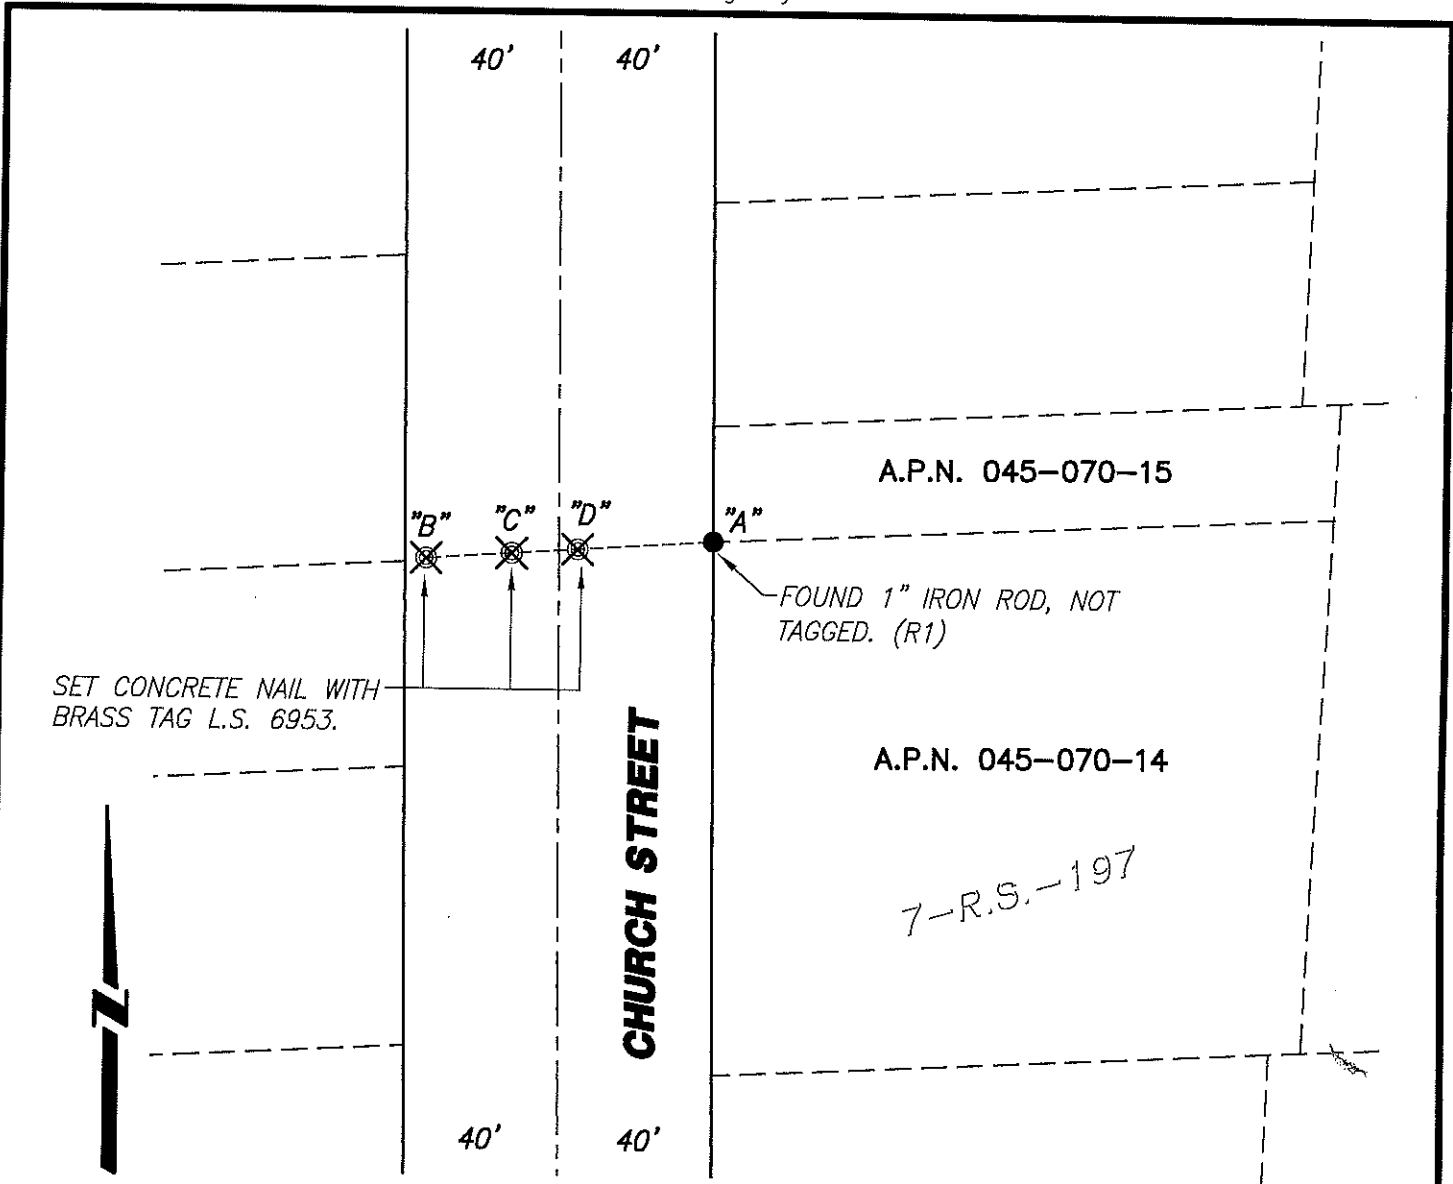

NOT TO SCALE

**LEGEND:**

- ⊗ SET MONUMENT AS NOTED.
- FOUND MONUMENT AS NOTED.
- R.S.- RECORD OF SURVEY
- S.J.C.R. SAN JOAQUIN COUNTY RECORDS
- (M) MEASURED DISTANCE. ALL DISTANCES ARE MEASURED UNLESS NOTED OTHERWISE.

BS-@-FS	⊗	FS DISTANCE
B-A-B	00°00'00"	70.90'(M)
B-A-C	00°00'00"	53.47'(M)
B-A-D	00°00'00"	39.78'(M)

**REFERENCE:**

(R1) 7-R.S.-197 S.J.C.R.

**NOTE:**

THIS CORNER RECORD DOES NOT VERIFY THIS MONUMENT TO BE IN THE CORRECT POSITION.