

CORNER RECORD

Agency Index: CR-17-308

Document Number: _____

City of STOCKTON

County of SAN JOAQUIN, California

Brief Legal Description FOUND MONUMENTS AT THE INTERSECTION OF PACIFIC AVENUE AND BENJAMIN HOLT DRIVE; MONUMENT "C" IS UNREFERENCED; MONUMENT "B" PER 35-S-5, S.J.C.R.



T.2N, R.6E

CORNER TYPE

- Government Corner
- Control
- Meander
- Property
- Rancho
- Other

Date of Survey 7-18-2017

COORDINATES (Optional)

- N. _____ E. _____
- Elevation _____
- Units Metric U.S. Survey Foot
- Horizontal Datum _____
- Zone _____ Epoch Date _____
- Vertical Datum _____
- Complies with Public Resources Code §§8801-8819
- Complies with Public Resources Code §§8890-8902

PLS Act Ref: 8765(d) 8771 8773 Other: _____

Corner/Monument: Left as found Established Rebuilt Pre-Construction
 Found and Tagged Reestablished Referenced Post-Construction

Narrative of corner identified and monument as found, set, reset, replaced, or removed:

See sheet #2 for description(s):

FOUND MONUMENTS; SET SIX (6) CONCRETE NAILS WITH BRASS TAG STAMPED "LS 6953" IN PAVEMENT AS WITNESS CORNERS, ALL AS SHOWN ON SHEET 2

SURVEYOR'S STATEMENT

This Corner Record was prepared by me or under my direction in conformance with the Land Surveyors' Act on JULY 28, 2017,



Signed [Signature] P.L.S. or R.C.E. Number 6953

COUNTY SURVEYOR'S STATEMENT

This Corner Record was received September 14, 2017


and examined and filed October 9, 2017

Signed [Signature] P.L.S. or R.C.E. No: 4842

Title County Surveyor



County Surveyor's Comment _____

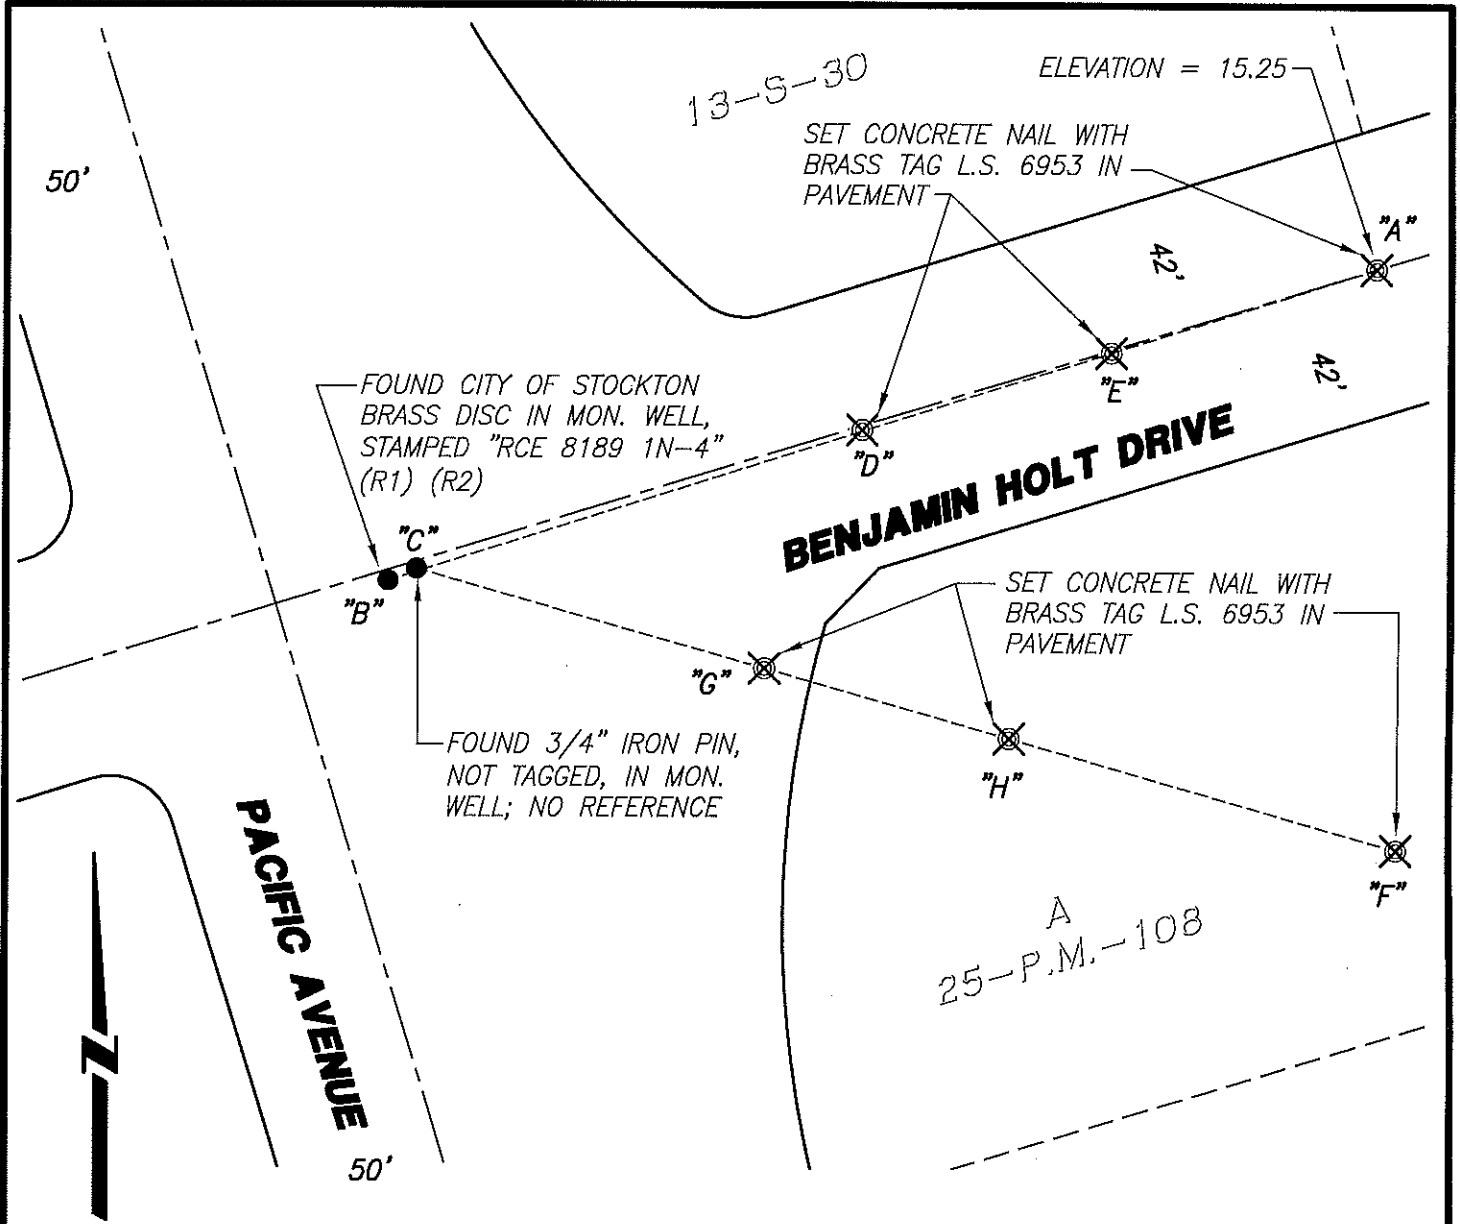

NOT TO SCALE

REFERENCE:

- (R1) 35-S-5 S.J.C.R.
- (R2) 25-P.M.-108, S.J.C.R.

LEGEND:

- ⊗ SET MONUMENT AS NOTED.
- FOUND MONUMENT AS NOTED.
- P.M.- PARCEL MAP
- S- RECORD OF SURVEY
- S.J.C.R. SAN JOAQUIN COUNTY RECORDS
- (M) MEASURED DISTANCE. ALL DISTANCES ARE MEASURED UNLESS NOTED OTHERWISE.

BS-@-FS	⚡	FS DISTANCE	ELEVATION
B-A-B	00°00'00"	318.20'(M)	13.42'
B-A-C	00°02'15"	313.47'(M)	--
B-A-D	00°00'00"	167.88'(M)	14.91'
B-A-E	00°00'00"	86.68'(M)	15.03'

BS-@-FS	⚡	FS DISTANCE
C-F-C	00°00'00"	340.42'(M)
C-F-B	359°50'40"	345.05'(M)
C-F-G	00°00'00"	227.40'(M)
C-F-H	00°00'00"	148.075'(M)

NOTE:

THIS CORNER RECORD DOES NOT VERIFY THIS MONUMENT TO BE IN THE CORRECT POSITION.