


CORNER RECORD

Agency Index CR-17-329
 Document Number _____

City of LODI County of SAN JOAQUIN, California
 Brief Legal Description _____

CORNER TYPE

COORDINATES (Optional)

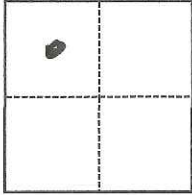

- Government Corner Control
 Meander Property
 Rancho Other

N. _____ E. _____
 Elevation _____
 Units Metric U.S. Survey Foot
 Horizontal Datum _____
 Zone _____ Epoch Date _____
 Vertical Datum _____
 Complies with Public Resources Code §§8801-8819
 Complies with Public Resources Code §§8890-8902

Date of Survey October 5, 2017

Sec 1 T. 3 N., R. 6 E.

- PLS Act Ref.: 8765(d) 8771 8773 Other:
 Corner/
 Monument: Left as found Established Rebuilt Pre-Construction
 Found and tagged Reestablished Referenced Post-Construction

Narrative of corner identified and monument as found, set, reset, replaced, or removed:
 See sheet #2 for description(s):

Fd. iron rod as shown on Parcel map Book 8, Pg. 22 San Joaquin County records. Iron rod is shown as being the northwest corner of Parcel A as shown on said map. Replaced with Mag Nail & Washer stamped "L.S. 6939". City of Lodi Construction Project covered over the monument. The monument may or may not have been destroyed.


SURVEYOR'S STATEMENT

This Corner Record was prepared by me or under my direction in conformance with the Professional Land Surveyors' Act on October 5, 2017
 Signed Michael D. Farley P.L.S. or R.C.E. No. L/S. 6939



COUNTY SURVEYOR'S STATEMENT

This Corner Record was received October 5, 2017
 and examined and filed October 10, 2017
 Signed Warren D. Smith P.L.S. or R.C.E. No. 4842
 Title County Surveyor

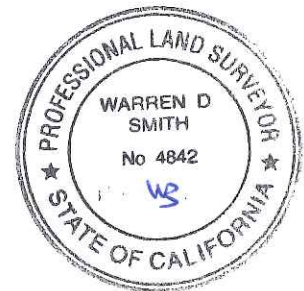

County Surveyor's Comment _____

No Scale



NOTE:

264' S

60'

60'

SCHOOL STREET

DEFORCE AVENUE

LOT 1

LOT 2

LOT 3

Fed. Pipe
(Plot & Field)
146.5'

Fed. 1. Rod

Fed. 1. Rod
150.0'

92 1/4'

(Plot & Field)

Fed. Nothing

Fed. Pipe
110' E.

Fed. 1. Rod

N. 20° 10' E. ALLEY

AVENUE

LOT 4

LOT 5
PARCEL 'A'
- 356± AC.

SET MAG NAIL
& WASHER
STAMPED
L.S. 69939

MORGAN - HANDEL
TRACT

Fed. 1. Rod
0.2 W.
0.4 S.

98.71'

N. 86° 00' W. Lot Line

N. 86° 00' W. Lot Line

157.31'

Fed. 1. Rod

Fed. 1. Rod
S. 86° 00' E.
20'

98.70'

500'

S. 20° 31' W.

SACRAMENTO STREET

60'

Fed. Nothing on East Right-of-

BLOCK

8