


# CORNER RECORD

Agency Index: CR-17-334

Document Number: \_\_\_\_\_

City of LATHROP County of SAN JOAQUIN, California

Brief Legal Description FOUND MONUMENT APPROX 348.5FT WEST OF THE INTERSECTION OF LATHROP RD AND 5TH STREET. LOCATED IN THE NORTHEAST QUARTER OF SECTION 26. T.1S, R.6E M.D.B.&M.

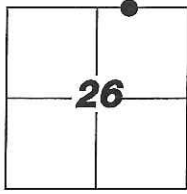

T.1S, R.6E

### CORNER TYPE

- Government Corner     Control  
 Meander                     Property  
 Rancho                          Other

Date of Survey 8-22-2017

### COORDINATES (Optional)

N. \_\_\_\_\_ E. \_\_\_\_\_

Elevation \_\_\_\_\_

Units  Metric  U.S. Survey Foot

Horizontal Datum \_\_\_\_\_

Zone \_\_\_\_\_ Epoch Date \_\_\_\_\_

Vertical Datum \_\_\_\_\_

Complies with Public Resources Code SS8801-8819

Complies with Public Resources Code SS8890-8902

PLS Act Ref:  8765(d)     8771     8773     Other:

Corner/  
 Monument:  Left as found     Established     Rebuilt     Pre-Construction  
 Found and Tagged     Reestablished     Referenced     Post-Construction

Narrative of corner identified and monument as found, set, reset, replaced, or removed:

See sheet #2 for description(s):

FOUND MONUMENT, NO REFERENCE; SET THREE (3) CONCRETE NAILS WITH BRASS TAG STAMPED "LS 6953" AS WITNESS CORNERS, ALL AS SHOWN ON SHEET 2

### SURVEYOR'S STATEMENT

This Corner Record was prepared by me or under my direction in conformance with the Land Surveyors' Act on SEPTEMBER 15, 2017,

Signed [Signature] P.L.S. or R.C.E. Number 6953




### COUNTY SURVEYOR'S STATEMENT

This Corner Record was received October 16, 2017


and examined and filed November 7, 2017

Signed [Signature] P.L.S. or R.C.E. No: 4842

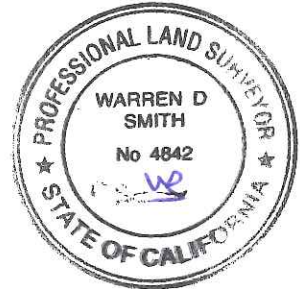

Title County Surveyor

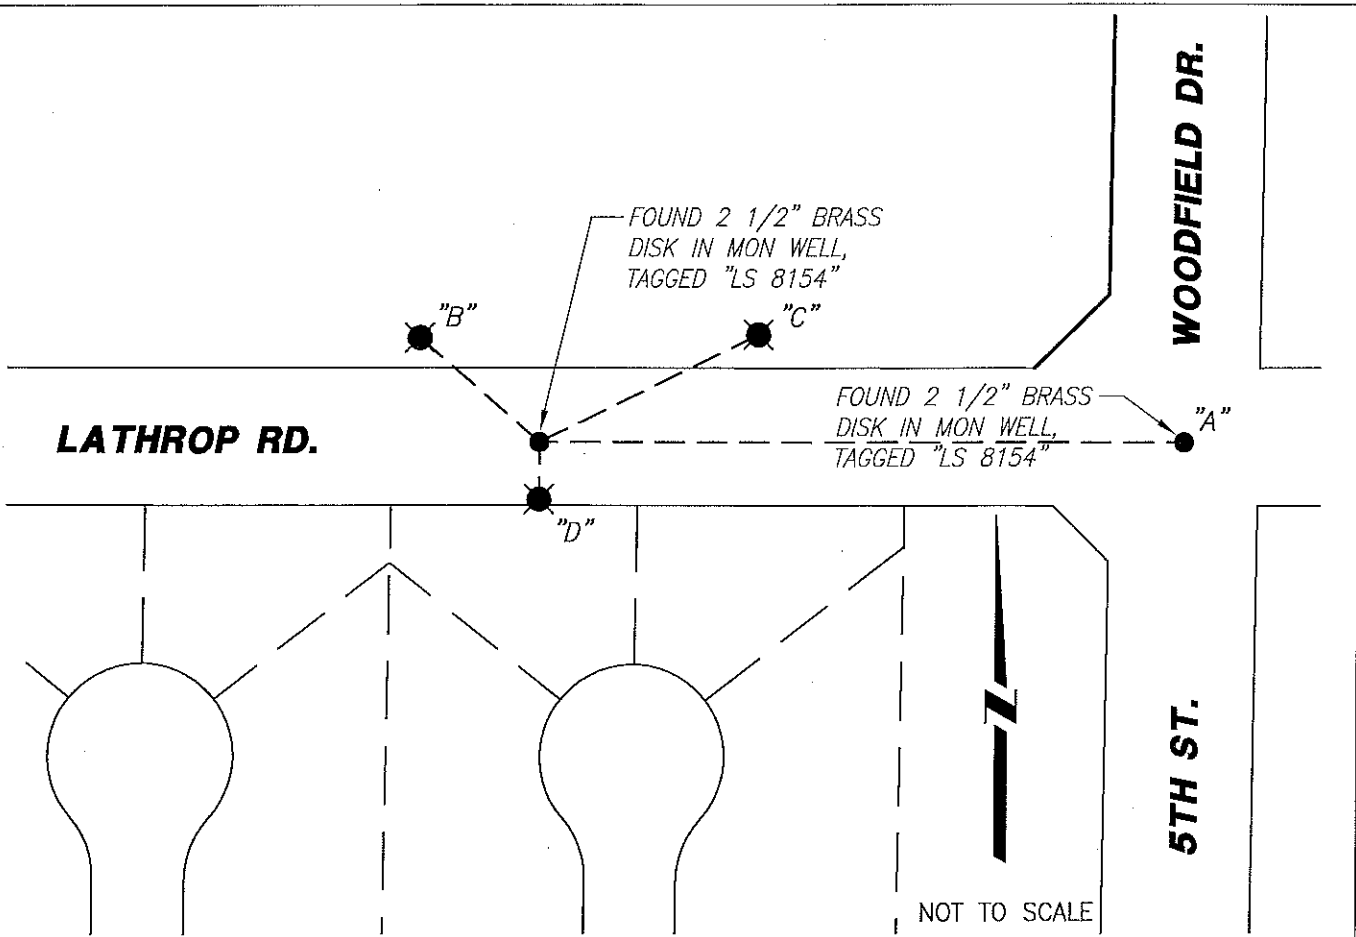

County Surveyor's Comment \_\_\_\_\_



**LEGEND:**

-  SET CONCRETE NAIL WITH BRASS TAG L.S. 6953.
-  FOUND MONUMENT AS NOTED.
- M&P- MAPS & PLATS
- S.J.C.R. SAN JOAQUIN COUNTY RECORDS
- (M) MEASURED DISTANCE. ALL DISTANCES ARE MEASURED UNLESS NOTED OTHERWISE.

∠ AND DISTANCE TABLE		
BS-@-FS	∠	FS DISTANCE
B-A-A	00°00'00"	348.490'(M)
B-A-B	221°24'15"	85.820'(M)
B-A-C	334°03'41"	131.915'(M)
B-A-D	90°00'00"	30.745'(M)

**NOTE:**

THIS CORNER RECORD DOES NOT VERIFY THIS MONUMENT TO BE IN THE CORRECT POSITION.