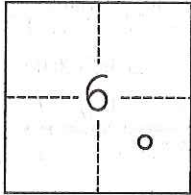


CORNER RECORD

Agency Index CR-17-347

Document Number _____

City of Unincorporated Area County of San Joaquin, CaliforniaBrief Legal Description The most southerly, southeast corner of Parcel 1, 23 P.M. 176T.4N., R.6E., M.D.M.**CORNER TYPE**
 Government Corner Control
 Meander Property
 Rancho Other
Date of Survey September 30, 2017**COORDINATES (Optional)**
 N. N/A E. N/A
 Elevation N/A
 Units Metric U.S. Survey Foot
 Horizontal Datum N/A
 Zone N/A Epoch Date N/A
 Vertical Datum N/A
 Complies with Public Resources Code §§8801-8819
 Complies with Public Resources Code §§8890-8902

 PLS Act Ref.: 8765(d) 8771 8773 Other:
 Corner/Monument: Left as found Established Rebuilt Pre-Construction
 Found and tagged Reestablished Referenced Post-Construction


Narrative of corner identified and monument as found, set, reset, replaced, or removed:

 See sheet #2 for description(s):

Reestablished the easterly line of Parcels 1, 2, and 3, per Parcel Map 23 P.M. 176. The most southerly, southeast corner of said Parcel 1 was not found. A 3/4" rebar with brass tag stamped "RW Snow LS8813" was set at said corner proportionate between the nearest found record survey monuments shown on said Parcel Map lying along said easterly line. The monument held to the north of this corner was not found tagged, therefore a brass tag stamped "RW Snow LS8813" was set on this found monument as well.

SURVEYOR'S STATEMENT

This Corner Record was prepared by me or under my direction in conformance with

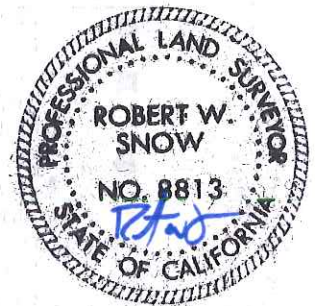the Professional Land Surveyors' Act on December 4, 2017Signed [Signature] P.L.S. or R.C.E. No. L8813**COUNTY SURVEYOR'S STATEMENT**This Corner Record was received December 4, 2017and examined and filed January 4, 2018Signed [Signature] P.L.S. or R.C.E. No. 4842Title County Surveyor

County Surveyor's Comment



