


CORNER RECORD

Agency Index CR-18-08
Document Number _____

City of _____ County of San Joaquin, California

Brief Legal Description ARMSTRONG ROAD 1326'± EAST OF DEVRIES ROAD
(On north line of Section 29, Township 3 North, Range 6 East, Mount Diablo Meridian)

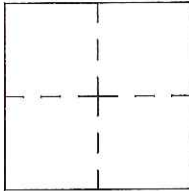

CORNER TYPE

Government Corner Control Elevation. _____
 Meander Property Units Metric U.S. Survey Foot
 Rancho Other Horizontal Datum _____
 Date of Survey March 20, 2017 Zone _____ Epoch Date _____
 Vertical Datum _____

Complies with Public Resources Code §§8801-8819
 Complies with Public Resources Code §§8890-8902

PLS Act Ref.: 8765(d) 8771 8773 Other: _____

Corner/Monument: Left as found Established Rebuilt Pre-Construction
 Found and tagged Reestablished Referenced Post-Construction

Narrative of corner identified and monument as found, set, reset, replaced, or removed:
 See sheet #2 for description(s):

SURVEYOR'S STATEMENT



This Corner Record was prepared by me or under my direction in conformance with the Professional Land Surveyor's Act on November 20, 2017.
Signed James E. Hart P.L.S. or R.C.E. No. 8657



COUNTY SURVEYOR'S STATEMENT

This Corner Record was received December 5, 2017
and examined and filed January 16, 2018
Signed Warren D. Smith P.L.S. or R.C.E. No. 4842
Title County Surveyor
County Surveyor's Comment _____



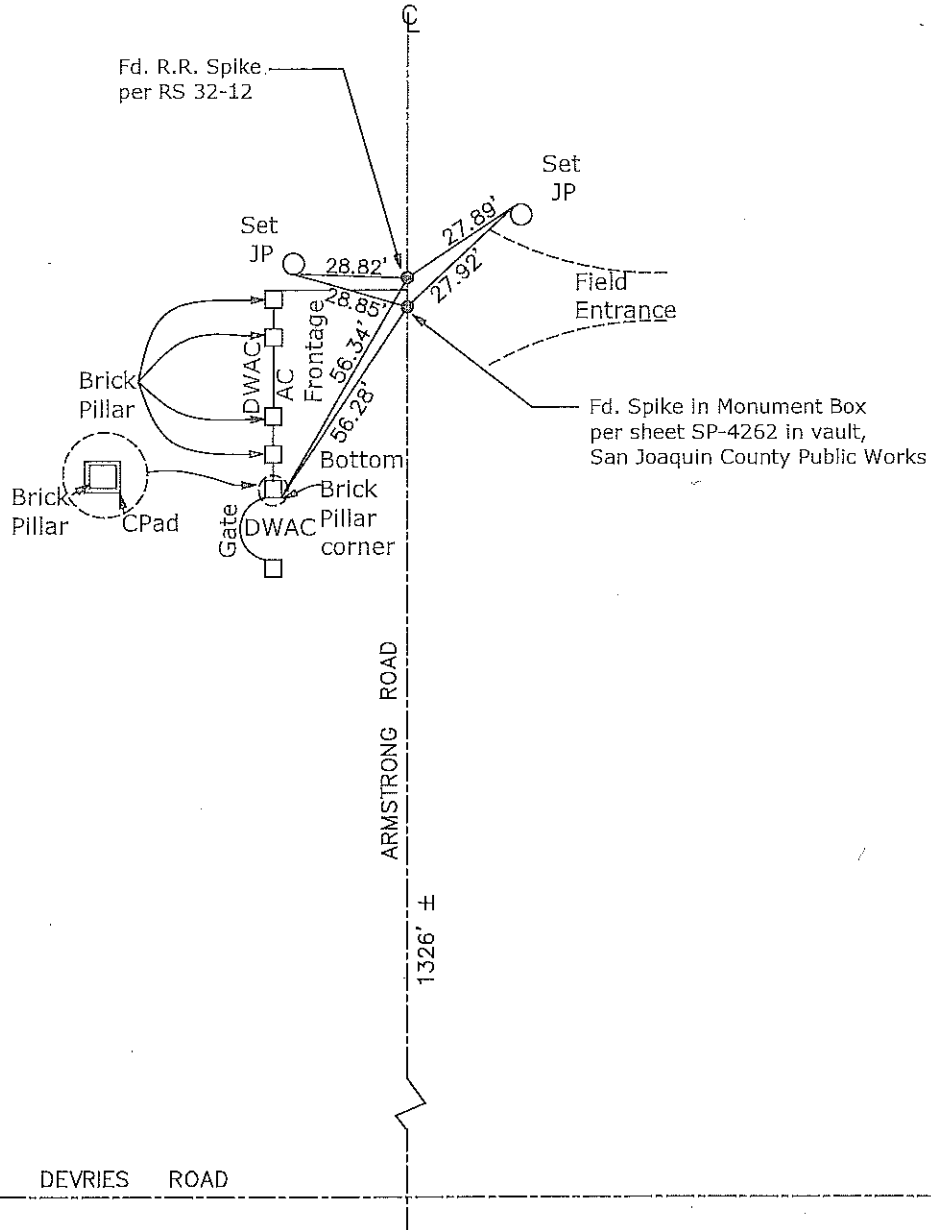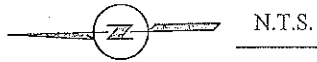

- AC=Asphalt concrete
- DWAC=Driveway Asphalt concrete
- CPad=concrete pad
- DWR=Driveway rocks
- CR=Corner Record
- FP=Fence Post
- JP=Joint Pole
- LP=Light Pole
- PP=Power Pole
- GP=Guy Pole
- SP=Service Pole
- TP=Telephone Pole
- S.F.N.=Searched Found Nothing
- N.T.S.=Not To Scale
- M&P=Maps & Plats
- PM=Parcel Map
- RS=Record of Survey
- FB=Field Book
- N=North
- DI=Drain Inlet
- TOC=Top of Curb

Set=Conc. Nail with Brass Washer Stamped
 "S.J. Co.", unless otherwise noted
 Fd.=Found Conc. Nail with Brass Washer Stamped
 "S.J. Co.", unless otherwise noted
 Note: Found Monuments are not tagged
 unless otherwise noted.

"No Attempt Was Made to Verify the Monument(s)"