
CORN	IER REC	CORD	Agency Index Document Number	
City of	STOCKTON	County of	SAN JOAC	QUIN , California
			RNER AS SHOWN	ON 32-R.S90
CORNER TYPE		COORDINATES (Optional)		
BLK. 77 SEC. 20 C.M.W. GRANT	Government Co Meander Rancho  Date of Survey	Control  Property Other  August 31, 2017	Units Metric  Horizontal Datum  Zone Epo  Vertical Datum  Complies with Public	E. U.S. Survey Foot  och Date  Resources Code §§8801-8819  Resources Code §§8890-8902
PLS Act Ref.:	8765(d)	8771	8773	Other:
Corner/ Monument:	Left as found Found and tagged	Established Reestablished	Rebuilt Referenced	Pre-Construction  Post-Construction
FOUND CHISELED SKETCH ON BACK	CROSS IN SIDEV	VALK AS SHOWN	ON 32-R.S90. LEF	
SURVEYOR'S STATEMENT  This Corner Record was prepared by me or under my direction in conformance with  the Professional Land Surveyors' Act on October 6, 2017  No. 8971				
Signed	MA .	P.L.S. or <del>.R.C.E.</del> No.	8971	OF CALIFORNIA
	COUNTY SURVEYOR	'S STATEMENT		
This Corner Record was record and examined and filed  Signed	January D. Imm	nber 14, 2017 18, 2018 _P.L.S. or <del>R.C.</del> E. No.	4842	WARREN D SMITH No 4842

**County Surveyor's Comment** 

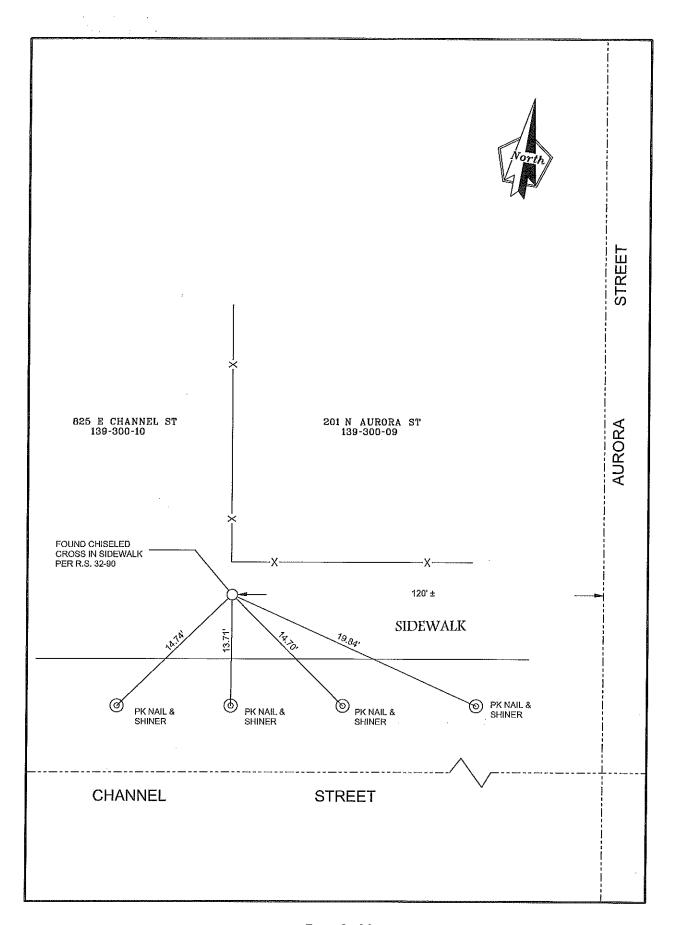

Page 2 of 2