


CORNER RECORD

Agency Index CR-18-27
Document Number _____

City of Lodi County of San Joaquin, California
Brief Legal Description Parcel 1; Book 22 of Parcel Maps, Page 87

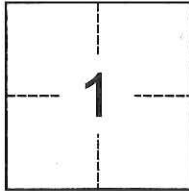

CORNER TYPE

Government Corner Control
Meander Property
Rancho Other

COORDINATES (Optional)

N. _____ E. _____
Elevation _____
Units Metric U.S. Survey Foot
Horizontal Datum _____
Zone _____ Epoch Date _____
Vertical Datum _____

Date of Survey December 5, 2017

T.3N., R.6E., M.D.B.& M.

Complies with Public Resources Code §§8801-8819
 Complies with Public Resources Code §§8890-8902

PLS Act Ref.: 8765(d) 8771 8773 Other:
Corner/Monument: Left as found Established Rebuilt Pre-Construction
 Found and tagged Reestablished Referenced Post-Construction

Narrative of corner identified and monument as found, set, reset, replaced, or removed:
 See sheet #2 for description(s):

It is the purpose of this corner record to establish ties to existing monuments prior to construction. The monuments were found and tied out as depicted on attached exhibit.

SURVEYOR'S STATEMENT

This Corner Record was prepared by me or under my direction in conformance with
the Professional Land Surveyors' Act on December 5, 2017
Signed [Signature] P.L.S. or R.C.E. No. 7889



COUNTY SURVEYOR'S STATEMENT


This Corner Record was received December 20, 2017
and examined and filed January 18, 2018
Signed [Signature] P.L.S. or R.C.E. No. 4842
Title County Surveyor



County Surveyor's Comment

S:\Projects\2016\16024\3_Drawings\16024_Sacramento-Oak.dwg 12/06/17 5:00pm-JELSON-XREYS-09x11_BP_P.dwg

Oak Street

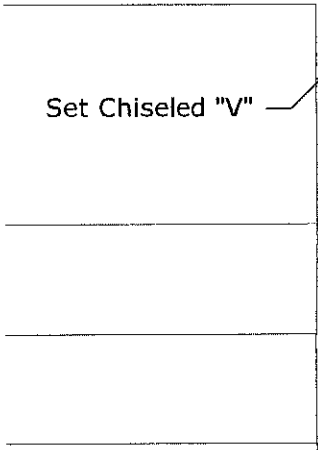

Set Chiseled "V"

S84° 57' 53"W

Found 3/4" Iron Rod per P.M. 22-87, capped and stamped "RCE 19638"

177.30'

S00° 00' 00"E 372.28'

Sacramento Street



Parcel 1
P.M. 22-87

Notes:

- 1. Monuments are not tagged unless noted.
- 2. No attempt was made to verify the monument(s)

Set Chiseled "V"

Walnut Street

N69° 23' 55"E 78.94'

Found Chiseled "X"

N89° 58' 29"E 102.50'

Found Chiseled "X"

70.74'

S80° 52' 03"E

Found Chiseled "X"

N80° 36' 29"W 152.75'

Found Mag Nail



PREPARED IN THE OFFICE OF:

BAUMBACH & PIAZZA, INC.

CIVIL ENGINEERS • SURVEYORS

www.bpengineers.net

209.368.6618

323 W. Elm St.

Lodi, CA 95240