# **CORNER RECORD**

**Document Number** LODI City of County of SAN JOAQUIN , California Brief Legal Description LOT 8, THE VILLAS AT SUNWEST, M&P 42-51, SEC 10, T3 N, R6 E, M.D.B.&M **CORNER TYPE COORDINATES (Optional)** N. Government Corner Control Elevation X U.S. Survey Foot Property Meander Units Metric Rancho Other Horizontal Datum Zone **Epoch Date** Date of Survey November 7, 2017 Vertical Datum Complies with Public Resources Code §§8801-8819 Complies with Public Resources Code §§8890-8902 PLS Act Ref.: X 8765(d) 8771 8773 Other: Left as found Established Rebuilt Pre-Construction Corner/ Monument: Found and tagged Reestablished Referenced Post-Construction Narrative of corner identified and monument as found, set, reset, replaced, or removed: See sheet #2 for description(s): SEARCHED FOUND NOTHING ON SOUTHEAST AND SOUTHWEST CORNERS OF LOT 8 OF THE VILLAS AT SUNWEST, MAPS AND PLATS 42 - 51. SET WITNESS CORNERS ON A 2' X 2' OFFSET AS SHOWN. SURVEYOR'S STATEMENT This Corner Record was prepared by me or under my direction in conformance with NO. 7600 the Professional Land Surveyors' Act on January 2, 2018 7600 Signed P.L.S. or R.C.E. No. **COUNTY SURVEYOR'S STATEMENT** January A, 2018 This Corner Record was received January 18, 2018 and examined and filed P.L.S. or R.G.E. No. 4842 Signed County Surveyor Title **County Surveyor's Comment** 

CR-18-29

Agency Index

# WONG ENGINEERS, INC.

PLANNING ENGINEERING SURVEYING 4578 FEATHER RIVER DRIVE, SUITE A STOCKTON, CALIFORNIA 95219 (209) 476-0011

## **DESCRIPTION:**

THIS DOCUMENT IS FOR THE PURPOSE OF RESETTING ANY MISSING OR OBLITERATED CORNERS FROM LOT 8 OF THE VILLAS AT SUNWEST AS SHOWN ON BOOK 42 OF MAPS & PLATS, PAGE 51, SAN JOAQUIN COUNTY RECORDS.

0.08' FROM P.C.(B)(C)

#### LEGEND:

**DENOTES FOUND** DENOTES IRON

DENOTES MEASURED

DENOTES PROPERTY CORNER P.C. DENOTES MAPS AND PLATS M&P

DENOTES REFERENCE REF.


- DENOTES FD. 3/4" I.PIN TAGGED L.S. 7600 PER REF. C
- DENOTES SET 3/4" I.PIN TAGGED L.S. 7600 0
- DENOTES FD. CHISELED CROSS WITH BRASS TAG X L.S. 7600 PER REF. C

#### NOTE:

### REFERENCES:

ALL BEARINGS AND DISTANCES ARE RECORD

(A) P.M. 21-38

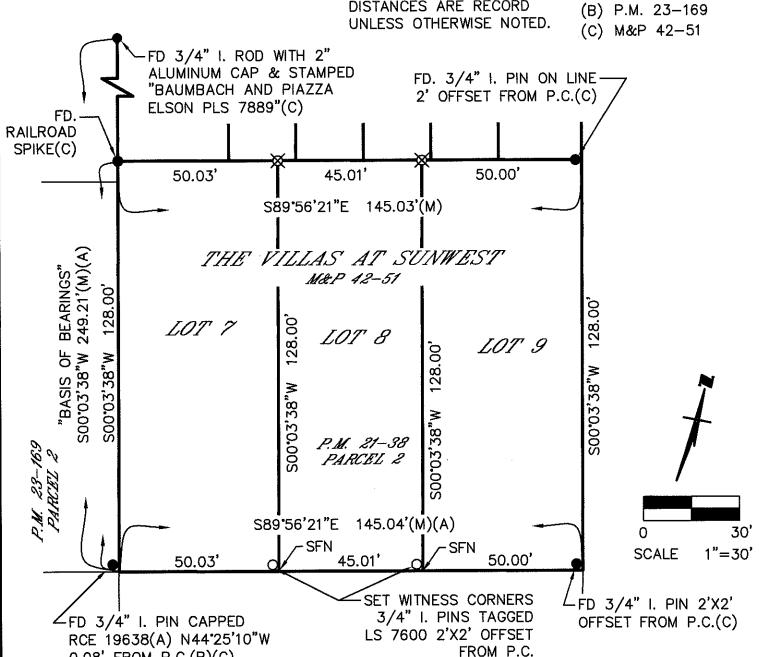

PAGE 2 OF 2