


CORNER RECORD

Agency Index CR-18-32
Document Number _____

City of _____ County of SAN JOAQUIN, California
Brief Legal Description PARCEL B, P.M. 8-120 IN SECTION 53, C.M. WEBER GRANT

CORNER TYPE

COORDINATES (Optional)

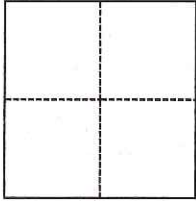

- Government Corner
- Meander
- Rancho
- Control
- Property
- Other

N. _____ E. _____

Elevation _____

Units Metric U.S. Survey Foot

Horizontal Datum _____

Zone _____ Epoch Date _____

Vertical Datum _____

Complies with Public Resources Code §§8801-8819

Complies with Public Resources Code §§8890-8902

PLS Act Ref.: 8765(d) 8771 8773 Other:

Corner/Monument: Left as found Established Rebuilt Pre-Construction

Found and tagged Reestablished Referenced Post-Construction

Narrative of corner identified and monument as found, set, reset, replaced, or removed:

See sheet #2 for description(s):

SEARCHED FOUND NOTHING AT LOCATIONS SHOWN FOR PARCEL B, PARCEL MAP, BOOK 8 PAGE 120. SET PROPERTY CORNERS AS SHOWN. FOUND BENT PROPERTY CORNER AT NORTHWEST CORNER OF PARCEL, REMOVED AND REPLACED.

SURVEYOR'S STATEMENT

This Corner Record was prepared by me or under my direction in conformance with

the Professional Land Surveyors' Act on January 2, 2018

Signed [Signature] P.L.S. or R.C.E. No. 7600



COUNTY SURVEYOR'S STATEMENT

This Corner Record was received January 4, 2018

and examined and filed January 18, 2018

Signed [Signature] P.L.S. or R.C.E. No. 4842

Title County Surveyor

County Surveyor's Comment






WONG ENGINEERS, INC.
 PLANNING ENGINEERING SURVEYING
 4578 FEATHER RIVER DRIVE, SUITE A
 STOCKTON, CALIFORNIA 95219
 (209) 476-0011

LEGEND:

- FD. DENOTES FOUND
 - I. DENOTES IRON
 - M DENOTES MEASURED
 - MON. DENOTES MONUMENT
 - P.C. DENOTES PROPERTY CORNER
 - PM DENOTES PARCEL MAP, BOOK & PAGE
 - RS DENOTES RECORD OF SURVEY, BOOK & PAGE
-
- ⊙ DENOTES FD. BRASS CAP STAMPED R.C.E. 8189 IN MON. BOX PER (B)
 - DENOTES SET 3/4" I.PIN TAGGED L.S. 7600, UNLESS OTHERWISE NOTED

DESCRIPTION:

THIS DOCUMENT IS FOR THE PURPOSE OF RESETTING ANY MISSING OR OBLITERATED CORNERS FROM THE PARCEL B, AS SHOWN ON BOOK 8 OF PARCEL MAP, PAGE 120, SAN JOAQUIN COUNTY RECORDS.

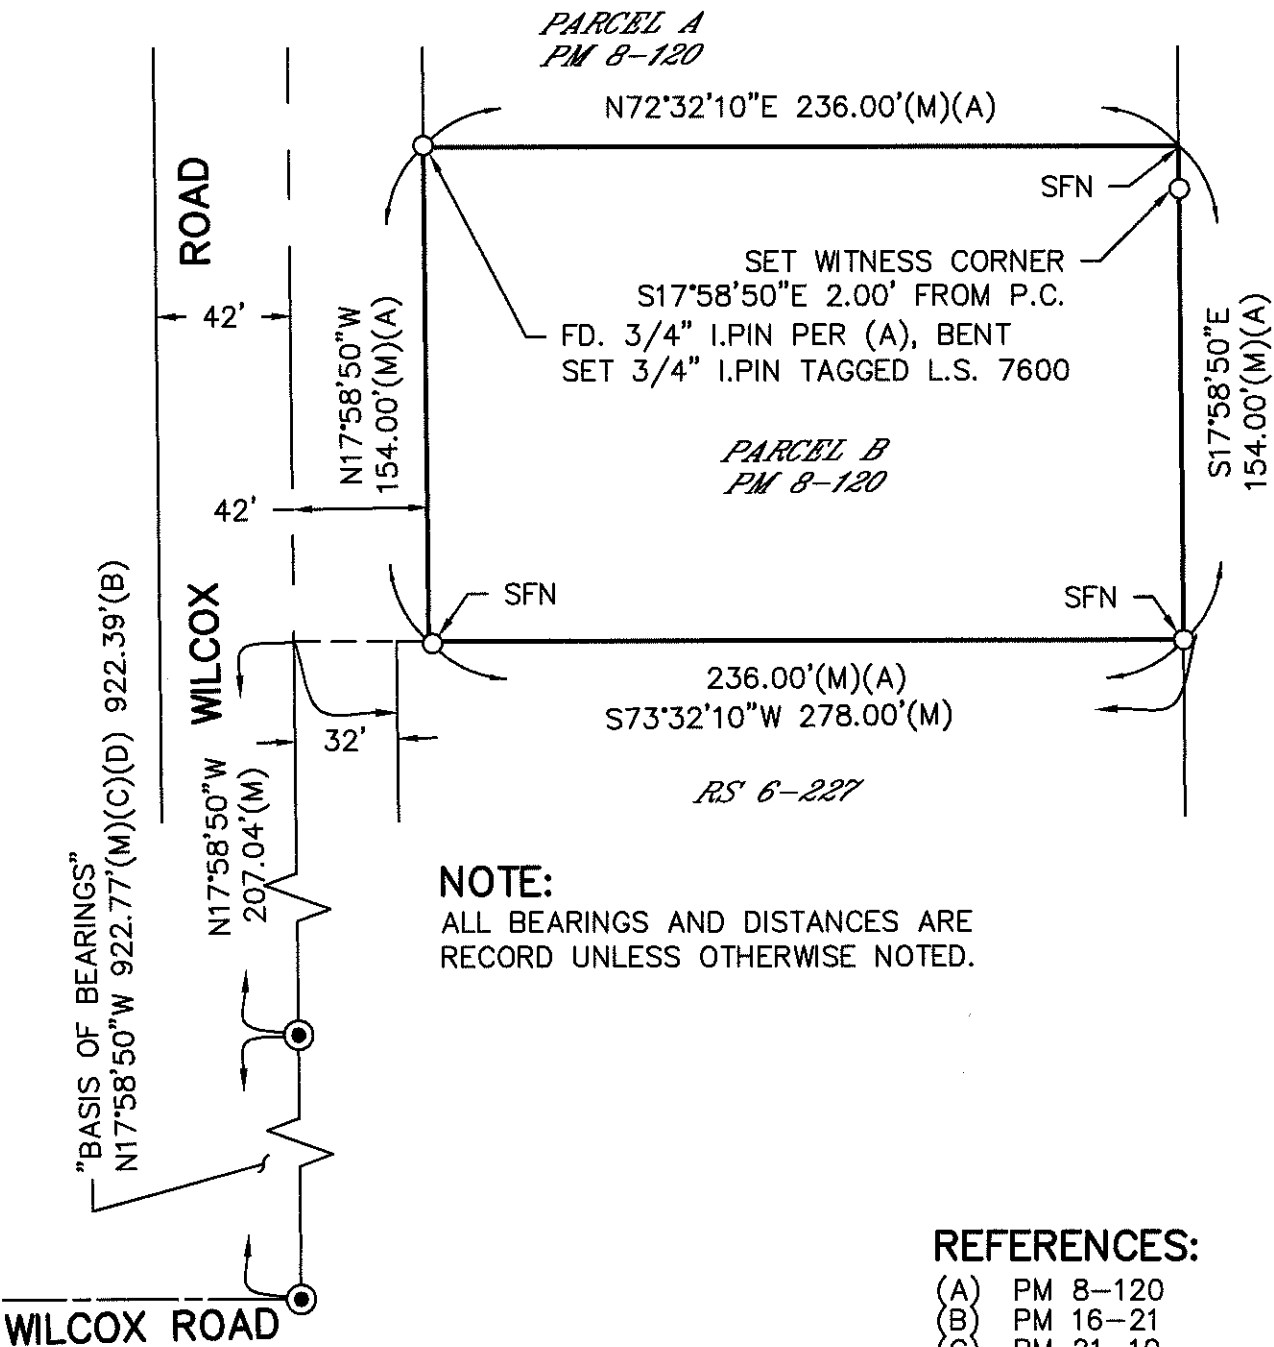

NOTE:
 ALL BEARINGS AND DISTANCES ARE RECORD UNLESS OTHERWISE NOTED.

REFERENCES:

- (A) PM 8-120
- (B) PM 16-21
- (C) PM 21-10
- (D) RS 32-143

