
CORNER RECORD City of County of	Agency Index
Brief Legal Description Section corner common to Sec	ctions 14, 15, 22 & 23, T.1N., R.9E., M.D.M.
CORNER TYPE Section Corner Control Control Control Meander Property Control Contr	COORDINATES (Optional) N. 2161509.33 E. 6428071.16 Elevation Units Metric U.S. Survey Foot Horizontal Datum CCS83 Zone 3 Epoch Date 2010 Vertical Datum Complies with Public Resources Code §§8801-8819 Complies with Public Resources Code §§8890-8902
Corner/ Monument: Left as found Established Reestablished	Rebuilt Pre-Construction Referenced Post-Construction
Narrative of corner identified and monument as found, set, reset, replaced, or removed: See sheet #2 for description(s): Found 1" Iron Pipe, tag destroyed, per R.S. 35-29 M.&P., S.J.C.R No attempt was made to determine validity of monument or its proper location in relation to the legal boundary lines in the area. Coordinates provided per static survey and conventional ties. See "Sheet 2". Surveyor's Statement	
This Corner Record was received and examined and filed Signed P.L.S. or R.C.E. No. Title County Surveyor County Surveyor's Comment	WARREN D SMITH

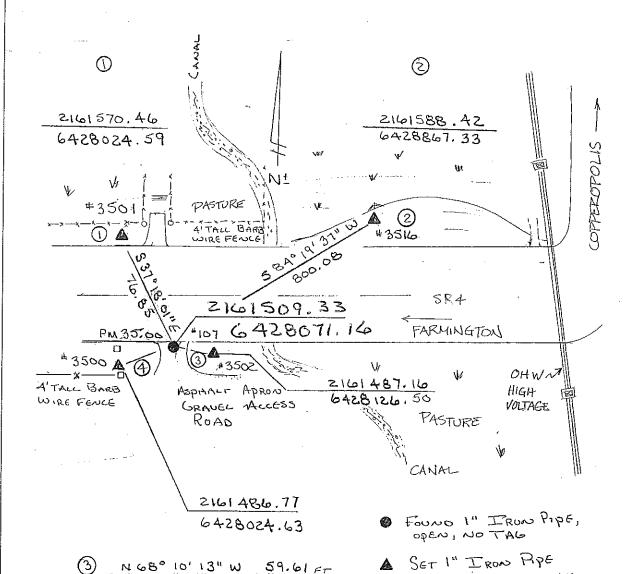

N 64° 08' 16" E 51.71 FT

CAP WITH PUNCH

STAMPED CALTIRANS