## **CORNER RECORD** CR-18-51 Agency Index **Document Number** STOCKTON City of SAN JOAQUIN County of California A PORTION OF BLOCK 95 AS SHOWN IN 25 PM 123 Brief Legal Description **CORNER TYPE COORDINATES (Optional)** E. Government Corner Control Elevation X U.S. Survey Foot Meander Property Units Metric Other Rancho Horizontal Datum Zone Epoch Date Date of Survey October 25, 2017 Vertical Datum C.M. WEBER GRANT Complies with Public Resources Code §§8801-8819 Complies with Public Resources Code §§8890-8902 8765(d) PLS Act Ref.: X 8771 8773 Other: Established Pre-Construction Left as found Rebuilt Corner/ Monument: Post-Construction Found and tagged Reestablished Referenced Narrative of corner identified and monument as found, set, reset, replaced, or removed: See sheet #2 for description(s): Found existing 3 property corners and 1 benchmark. Set control points to reestablish if necessary at post construction. SURVEYOR'S STATEMENT This Corner Record was prepared by me or under my direction in conformance with the Professional Land Surveyors' Act on November 3, 2017 PLS 8513 P.L.S. or R.C.E. No. Signed COUNTY SURVEYOR'S STATEMENT

February 16, 2018

P.L.S. or R.C.E. No. 4842

This Corner Record was received

**County Surveyor's Comment** 

Surveyor

and examined and filed

Signed

Title

No 4842



STATEMENT OF PURPOSE:

THE PURPOSE OF THIS SURVEY IS TO RECORD THE LOCATION OF 3 PROPERTY CORNERS AND 1 BENCHMARK PER SHEET C-3 OF THE MONUMENT REESTABLISHMENT PLAN AT 510 & 520 NORTH EL DORADO STREET PRIOR TO CONSTRUCTION.


## REFERENCES:

7041

PARCEL MAP BOOK 25 PAGE 123

## LEGEND:

- FOUND 1" BRASS CAP PER (R1)
- FOUND CUT BOX ON TOP OF CURB
- SET MAG NAIL
- ◆ SET CHISELED CROSS

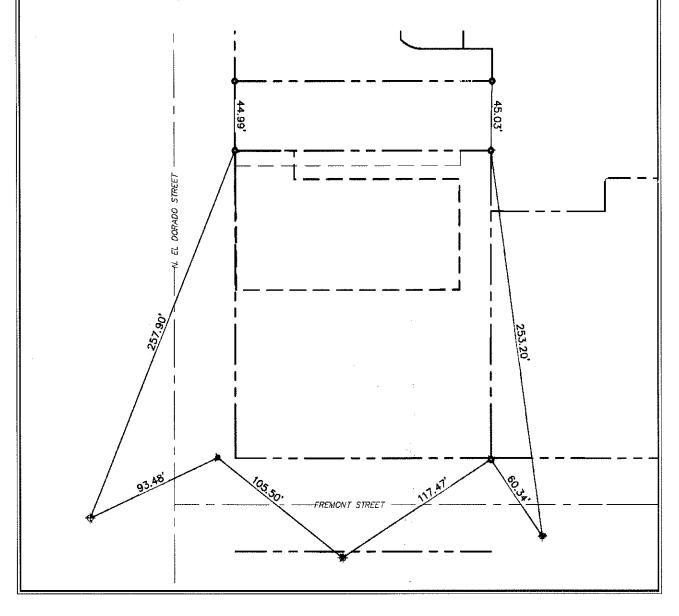

BPELSG-2016