
## CORNER RECORD

CR-18-52 Agency Index Document Number San Joaquin City of County of Apparent intersection Hwy 88 and Fairchild Lane Brief Legal Description COORDINATES (Optional) **CORNER TYPE** N. Government Corner Control Elevation U.S. Survey Foot Meander Property Units Metric Rancho Other Horizontal Datum Epoch Date Zone Date of Survey December 28, 2017 Vertical Datum C.M. WEBER GRANT Complies with Public Resources Code §§8801-8819 Complies with Public Resources Code §§8890-8902 PLS Act Ref.: 8765(d) X 8771 Other: Established Pre-Construction Left as found Rebuilt Corner/ Monument: Found and tagged Reestablished X Referenced X Post-Construction Narrative of corner identified and monument as found, set, reset, replaced, or removed: ✓ See sheet #2 for description(s): Monument well was raised during overlay project. Some of the existing ties were destroyed. New ties were added as shown on sheet 2. SURVEYOR'S STATEMENT SPENCER This Corner Record was prepared by me or under my direction in conformance with No. 6408 the Professional Land Surveyors' Act on January 31, 2018 LS 6406 P.L.S. or R.C.E. No. Signed **COUNTY SURVEYOR'S STATEMENT** February 1, 2018 This Corner Record was received and examined and filed P.L.S. or <del>R.C.E.</del> No. <u>4842</u> No 4842 Signed County Surveyor Title

**County Surveyor's Comment** 

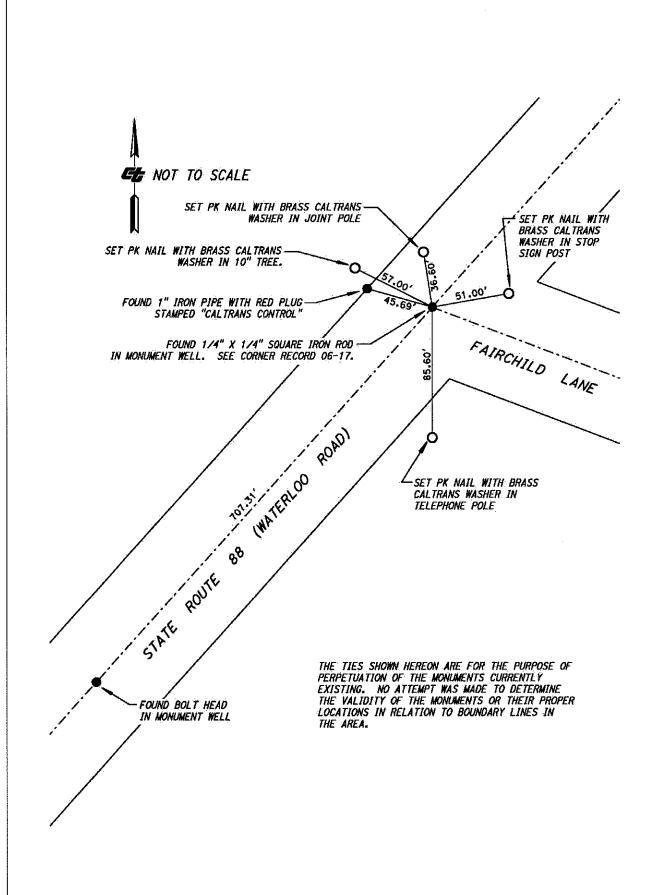

BPELSG-2016 Page 2 of 2