


# CORNER RECORD

Agency Index CR-18-60  
Document Number \_\_\_\_\_

City of Manteca County of San Joaquin, California  
Brief Legal Description NE corner of Harvest Ln & Woodward Ave., Section 7, T2S, R7E, M.D.B.M.

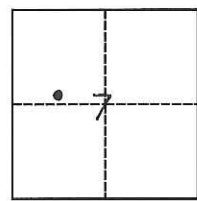

T2S, R7E, MDM

### CORNER TYPE

- Government Corner  Control
- Meander  Property
- Rancho  Other

Date of Survey December 1, 2017

### COORDINATES (Optional)

N. \_\_\_\_\_ E. \_\_\_\_\_

Elevation 30.12

Units Metric  U.S. Survey Foot

Horizontal Datum \_\_\_\_\_

Zone \_\_\_\_\_ Epoch Date \_\_\_\_\_

Vertical Datum NAVD 88

- Complies with Public Resources Code §§8801-8819
- Complies with Public Resources Code §§8890-8902

PLS Act Ref.:  8765(d)  8771  8773  Other:

Corner/Monument:  Left as found  Established  Rebuilt  Pre-Construction

Found and tagged  Reestablished  Referenced  Post-Construction

Narrative of corner identified and monument as found, set, reset, replaced, or removed:  
 See sheet #2 for description(s):



### SURVEYOR'S STATEMENT

This Corner Record was prepared by me or under my direction in conformance with the Professional Land Surveyors' Act on January 8, 2018.

Signed Douglas F. Banks P.L.S. or R.C.E. No. PLS 8159

### COUNTY SURVEYOR'S STATEMENT


This Corner Record was received February 1, 2018 and examined and filed March 2, 2018.

Signed Warren D. Smith P.L.S. or R.C.E. No. 4842

Title County Surveyor

County Surveyor's Comment



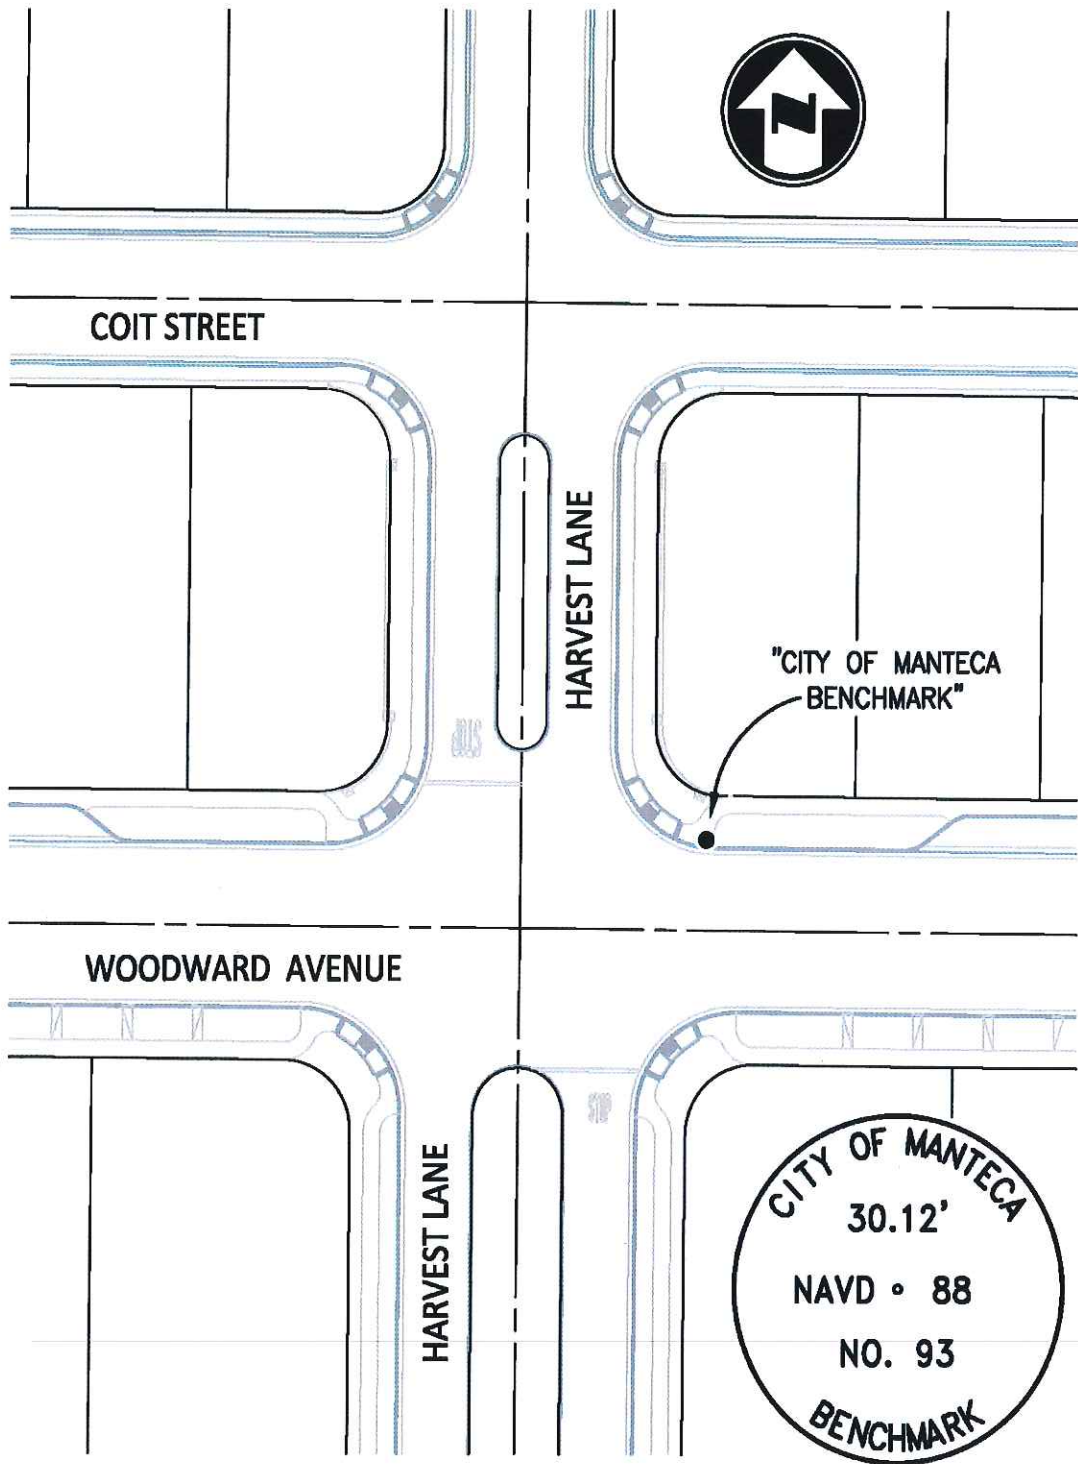

A COPY OF THE FIELD NOTES WILL BE KEPT ON FILE AT THE CITY OF MANTECA. THE BENCH LOOP WAS CONDUCTED USING 2ND ORDER DIFFERENTIAL LEVELING METHOD WITH A LEICA MODEL DNA03 ELECTRONIC/DIGITAL LEVEL AND BAR CODE RODS, TO EXTEND THE NGS BENCHMARK NO. HSO211, A NON-MAGNETIC DISK SET IN THE CULVERT HEADWALL STAMPED "U.S. COAST & GEODETIC SURVEY ELEV. 49.478 FEET ABOVE MEAN SEA LEVEL F83 1930" WITH A COMBINED NAVD 88 ELEVATION OF 51.48', TO THE NEW 2" BRASS DISK SET IN CONCRETE CURB OF THE NE CORNER OF HARVEST LANE AND WOODWARD AVENUE STAMPED "CITY OF MANTECA BENCHMARK NO. 93 NAVD 88 30.12'" WITH A NAVD 88 ELEVATION OF 30.12'.