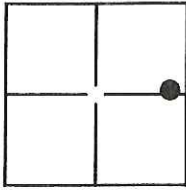


# CORNER RECORD

Agency Index: CR-18-66

Document Number: \_\_\_\_\_

City of STOCKTON County of SAN JOAQUIN, CaliforniaBrief Legal Description MONUMENT ON THE NORTH SIDE OF HAMMER LANE APPROXIMATELY 494'± WEST OF THE CENTERLINE OF MISTY LANE. LOCATED IN THE EAST HALF OF SECTION 17, T.2N, R.6E, M.D.B.&M.SEC. 17  
T.2N, R.6E**CORNER TYPE**
 Government Corner  Control   
 Meander  Property   
 Rancho  Other 
Date of Survey 2-9-2018**COORDINATES (Optional)**

N. \_\_\_\_\_ E. \_\_\_\_\_

Elevation: \_\_\_\_\_

Units Metric  U.S. Survey Foot 

Horizontal Datum: \_\_\_\_\_

Zone: \_\_\_\_\_ Epoch Date: \_\_\_\_\_

Vert. Datum: \_\_\_\_\_


 Complies with Public Resources Code §§8801-8819 Complies with Public Resources Code §§8890-8902PLS Act Ref:  8765(d)  8771  8773  Other:
 Corner/Monument:  Left as found  Established  Rebuilt  Pre-Construction  
 Found and Tagged  Reestablished  Referenced  Post-Construction

Narrative of corner identified and monument as found, set, reset, replaced, or removed:

 See sheet #2 for description(s):
FOUND 3/4" IRON PIPE NO TAG ON THE NORTH SIDE OF HAMMER LANE APPROXIMATELY 494'± WEST OF MISTY LANE. LOCATED IN THE EAST HALF OF SECTION 17, T.2N, R.6E, M.D.B.&M. FOUND MONUMENT AS AS SHOWN ON RECORD OF SURVEY FILED IN BOOK 8 OF SURVEYS AT PAGE 42, SAN JOAQUIN COUNTY RECORDS.
**SURVEYOR'S STATEMENT**
 This Corner Record was prepared by me or under my direction in conformance with the Land Surveyors' Act on FEBRUARY 14, 2018,

 Signed [Signature] P.L.S. or R.C.E. Number 6953
**COUNTY SURVEYOR'S STATEMENT**This Corner Record was received February 27, 2018and examined and filed March 13, 2018
 Signed [Signature] P.L.S. or R.C.E. No: 4842
Title County Surveyor

County Surveyor's Comment \_\_\_\_\_

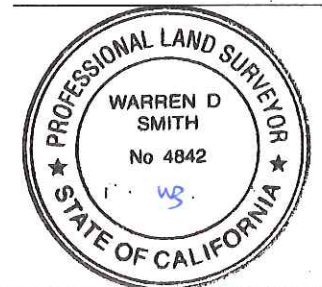

**LEGEND:**

- ⊗ SET MONUMENT AS NOTED.
- FOUND MONUMENT AS NOTED.
- R.S. DENOTES RECORD OF SURVEY
- (M) MEASURED DISTANCE. ALL DISTANCES ARE MEASURED UNLESS NOTED OTHERWISE.

**REFERENCE:**


(R1) R.S. 8-42, S.J.C.R.

HAMMER LANE

BRENTWOOD DRIVE

*χ* AND DISTANCE TABLE

BS-@-FS	<i>χ</i>	FS DISTANCE
B-A-B	00°00'00"	202.62'(M)
B-A-C	00°00'00"	102.02'(M)
B-A-D	252°17'17"	112.81'(M)

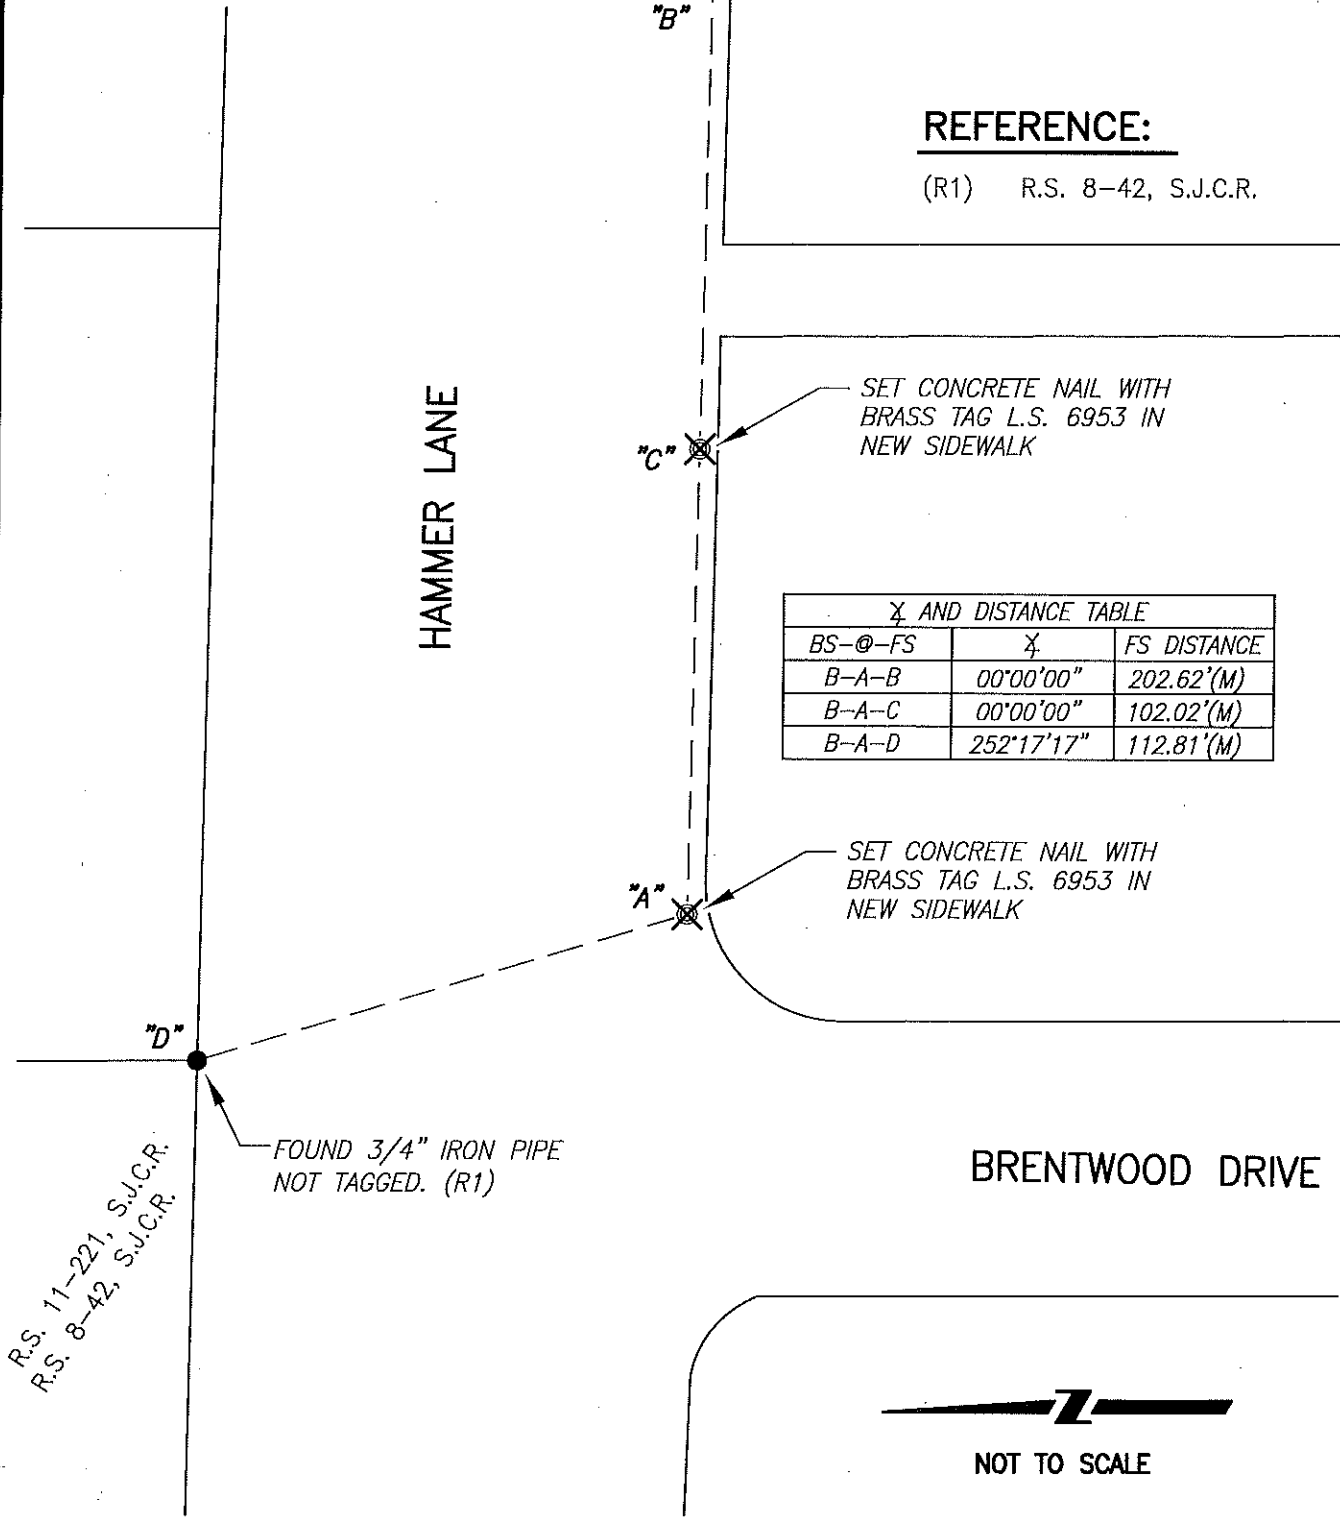

NOT TO SCALE

R.S. 11-221, S.J.C.R.  
R.S. 8-42, S.J.C.R.

FOUND 3/4" IRON PIPE  
NOT TAGGED. (R1)