


# CORNER RECORD

Agency Index CR-18-80  
 Document Number \_\_\_\_\_

City of \_\_\_\_\_ County of San Joaquin, California

Brief Legal Description CHICKASAW WAY @ CHICKASAW COURT  
 (Within Section 21, Township 1 South, Range 7 East, Mount Diablo & Meridian)

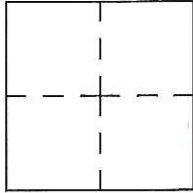

**CORNER TYPE**

**COORDINATES (Optional)**

Government Corner  Control   
 Meander  Property   
 Rancho  Other

N. \_\_\_\_\_ E. \_\_\_\_\_  
 Elevation. \_\_\_\_\_

Date of Survey March 13, 2018

Units Metric  U.S. Survey Foot

Horizontal Datum \_\_\_\_\_

Zone \_\_\_\_\_ Epoch Date \_\_\_\_\_

Vertical Datum \_\_\_\_\_

Complies with Public Resources Code §§8801-8819

Complies with Public Resources Code §§8890-8902

PLS Act Ref.:  8765(d)  8771  8773  Other:

Corner/Monument:  Left as found  Established  Rebuilt  Pre-Construction

Found and tagged  Reestablished  Referenced  Post-Construction

Narrative of corner identified and monument as found, set, reset, replaced, or removed:

See sheet #2 for description(s):

**SURVEYOR'S STATEMENT**

This Corner Record was prepared by me or under my direction in conformance with  
 the Professional Land Surveyor's Act on March 22, 2018

Signed James E. Hart P.L.S. or R.C.E. No. 8657



**COUNTY SURVEYOR'S STATEMENT**

This Corner Record was received March 26, 2018



and examined and filed March 28, 2018

Signed Warren D. Smith P.L.S. or R.C.E. No. 4842

Title County Surveyor

County Surveyor's Comment



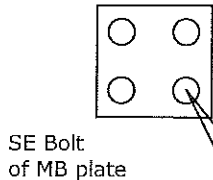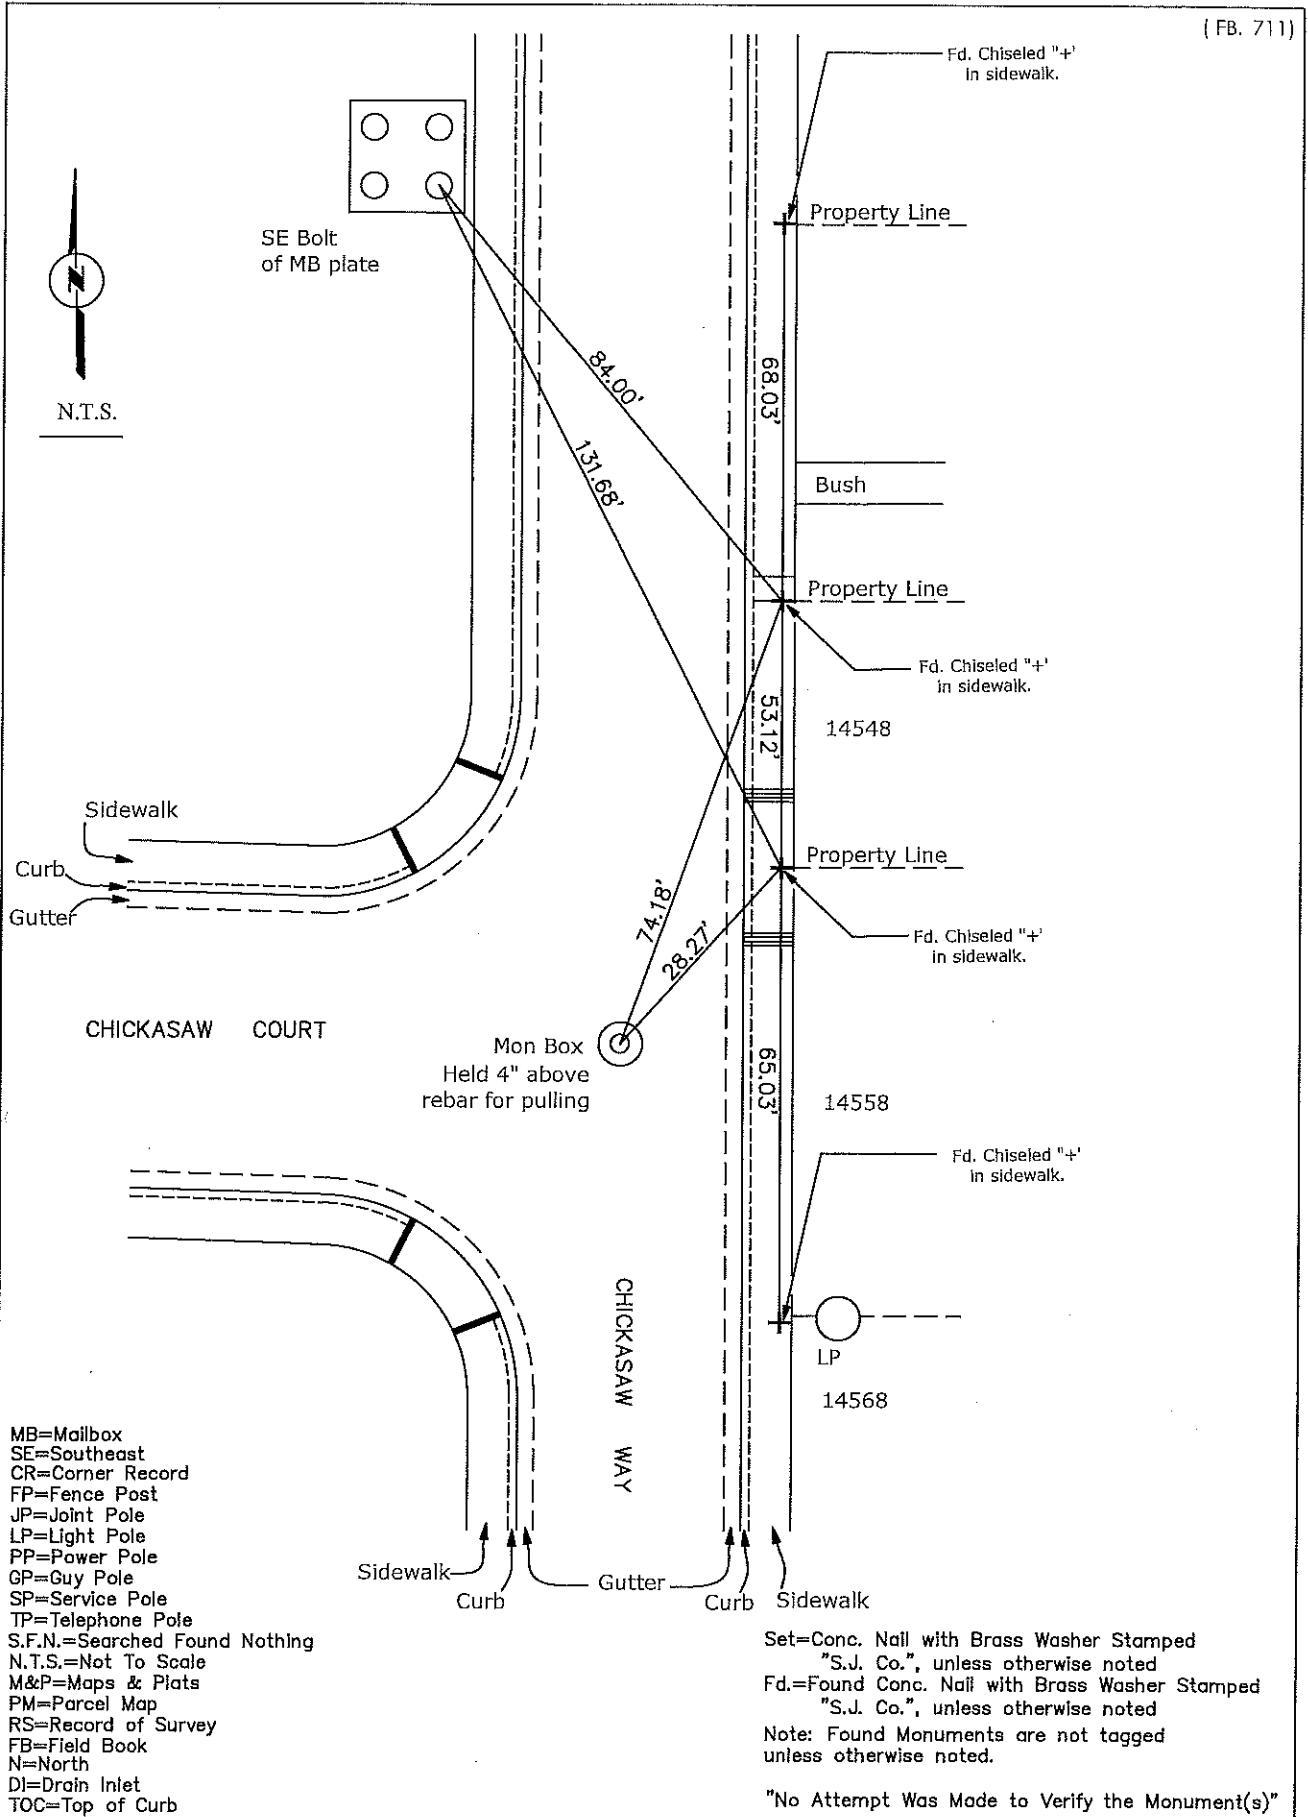

Fd. Chiseled "+" in sidewalk.

Property Line

Bush

Property Line

Fd. Chiseled "+" in sidewalk.

14548

Property Line

Fd. Chiseled "+" in sidewalk.

14558

Fd. Chiseled "+" in sidewalk.

LP

14568

CHICKASAW COURT

CHICKASAW WAY

Mon Box  
Held 4" above  
rebar for pulling

Sidewalk  
Curb  
Gutter

Sidewalk  
Curb  
Gutter  
Curb  
Sidewalk

- MB=Mailbox
- SE=Southeast
- CR=Corner Record
- FP=Fence Post
- JP=Joint Pole
- LP=Light Pole
- PP=Power Pole
- GP=Guy Pole
- SP=Service Pole
- TP=Telephone Pole
- S.F.N.=Searched Found Nothing
- N.T.S.=Not To Scale
- M&P=Maps & Plats
- PM=Parcel Map
- RS=Record of Survey
- FB=Field Book
- N=North
- DI=Drain Inlet
- TOC=Top of Curb

Set=Conc. Nail with Brass Washer Stamped "S.J. Co.", unless otherwise noted  
 Fd.=Found Conc. Nail with Brass Washer Stamped "S.J. Co.", unless otherwise noted  
 Note: Found Monuments are not tagged unless otherwise noted.

"No Attempt Was Made to Verify the Monument(s)"