

# CORNER RECORD

Agency Index CR-18-88


Document Number \_\_\_\_\_

City of \_\_\_\_\_ County of San Joaquin, California

Brief Legal Description East line of Parcel One and East and South line of Parcel Two per Doc. No. 2005-193370 and North and East line per Doc. No. 2011-163090

### CORNER TYPE

### COORDINATES (Optional)

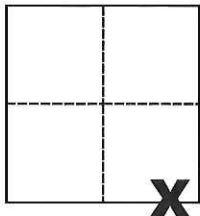

Government Corner  Control   
 Meander  Property   
 Rancho  Other

N. \_\_\_\_\_ E. \_\_\_\_\_

Elevation \_\_\_\_\_

Units Metric  U.S. Survey Foot

Horizontal Datum \_\_\_\_\_

Zone \_\_\_\_\_ Epoch Date \_\_\_\_\_

Date of Survey May 22, 2017

Vertical Datum \_\_\_\_\_

Sec. 15 and 22, T.1S., R.7E.,  
M.D.B. & M.

Complies with Public Resources Code §§8801-8819

Complies with Public Resources Code §§8890-8902

PLS Act Ref.:  8765(d)  8771  8773  Other:

Corner/Monument:  Left as found  Established  Rebuilt  Pre-Construction

Found and tagged  Reestablished  Referenced  Post-Construction

Narrative of corner identified and monument as found, set, reset, replaced, or removed:

See sheet #2 for description(s):

### SURVEYOR'S STATEMENT

This Corner Record was prepared by me or under my direction in conformance with

the Professional Land Surveyors' Act on Mar. 22, 2018

Signed Michael L. Quartararo P.L.S. or R.C.E. No. L.S. 4450



### COUNTY SURVEYOR'S STATEMENT

This Corner Record was received March 22, 2018

and examined and filed March 29, 2018

Signed Warren D. Smith P.L.S. or R.C.E. No. 4842


Title County Surveyor

County Surveyor's Comment \_\_\_\_\_



# REFERENCES

- (A) R.S. 38-1, S.J.C.R.
- (B) R.S. 10-81, S.J.C.R.
- (C) R.S. 11-8, S.J.C.R.
- (D) R.S. 6-131, S.J.C.R.
- (E) R.S. 37-115, S.J.C.R.

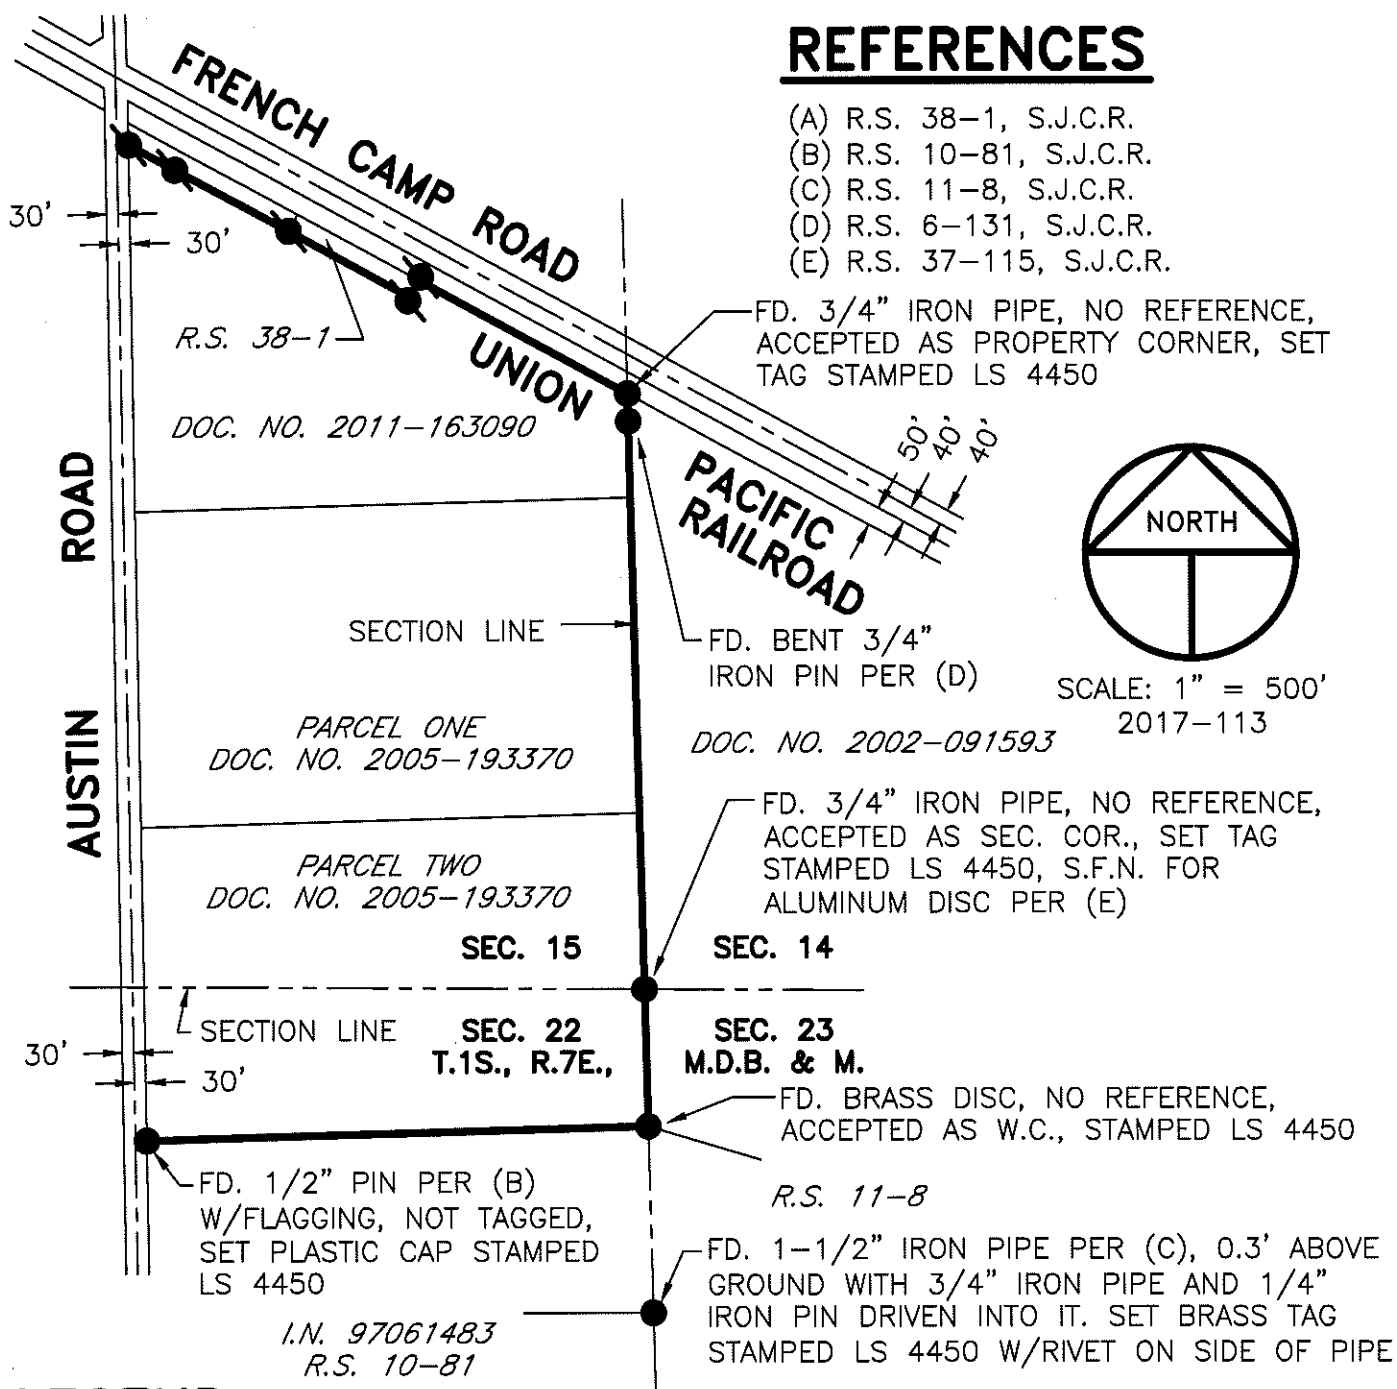

# LEGEND

- INDICATES FOUND MONUMENT AS NOTED
- INDICATES FOUND 3/4" IRON PIPE W/TAG STAMPED LS 4450 PER (A)
- INDICATES SET 3/4" IRON PIPE W/TAG STAMPED LS 4450, UNLESS OTHERWISE NOTED
- FD. INDICATES FOUND ON THIS SURVEY
- R.S. INDICATES RECORD OF SURVEY, BOOK AND PAGE, S.J.C.R.
- DOC. NO. INDICATES DOCUMENT NUMBER, S.J.C.R.
- I.N. INDICATES INSTRUMENT NUMBER, S.J.C.R.
- S.J.C.R. INDICATES SAN JOAQUIN COUNTY RECORDS
- W.C. INDICATES WITNESS CORNER

R.S. 6-131