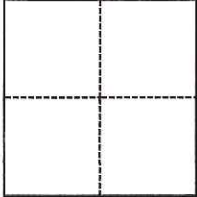


# CORNER RECORD

Agency Index CR-18-108

Document Number \_\_\_\_\_

City of STOCKTON County of SAN JOAQUIN, CaliforniaBrief Legal Description LOTS 3 & 4 PER "SOUTH-STOCKTON GARDEN FARMS" (M&P 9-35)**CORNER TYPE****COORDINATES (Optional)**

- Government Corner     Control  
 Meander                     Property  
 Rancho                         Other

Date of Survey APRIL 18, 2018

N. \_\_\_\_\_ E. \_\_\_\_\_

Elevation \_\_\_\_\_

Units     Metric             U.S. Survey Foot

Horizontal Datum \_\_\_\_\_

Zone \_\_\_\_\_ Epoch Date \_\_\_\_\_

Vertical Datum \_\_\_\_\_

 Complies with Public Resources Code §§8801-8819 Complies with Public Resources Code §§8890-8902PLS Act Ref.:     8765(d)                     8771                     8773                     Other:

Corner/  
 Monument:     Left as found             Established             Rebuilt                     Pre-Construction  
                       Found and tagged        Reestablished            Referenced                Post-Construction

Narrative of corner identified and monument as found, set, reset, replaced, or removed:

 See sheet #2 for description(s):**SURVEYOR'S STATEMENT**

This Corner Record was prepared by me or under my direction in conformance with

the Professional Land Surveyors' Act on MAY 3, 2018Signed Zachary C. Wong P.L.S. or R.C.E. No. 7600**COUNTY SURVEYOR'S STATEMENT**This Corner Record was received May 14, 2018and examined and filed May 14, 2018Signed James E. Hart P.L.S. or R.C.E. No. 8657Title Acting County Surveyor

County Surveyor's Comment \_\_\_\_\_






**WONG ENGINEERS, INC.**  
 PLANNING ENGINEERING SURVEYING  
 4578 FEATHER RIVER DRIVE, SUITE A  
 STOCKTON, CALIFORNIA 95219  
 (209) 476-0011

**LEGEND:**

- B.O.B. DENOTES BASIS OF BEARINGS
- CR DENOTES CORNER RECORD
- FD. DENOTES FOUND
- I. DENOTES IRON
- M DENOTES MEASURED
- M&P DENOTES MAPS & PLATS, BOOK & PAGE
- MON. DENOTES MONUMENT
- P.C. DENOTES PROPERTY CORNER
- RS DENOTES RECORD OF SURVEY, BOOK & PAGE
- SFN DENOTES SEARCHED, FOUND NOTHING
- DENOTES SET 3/4" I.PIN TAGGED L.S. 7600, UNLESS OTHERWISE NOTED
- ⊙ DENOTES MONUMENT BOX
- DENOTES FOUND MONUMENT AS NOTED

**DESCRIPTION:**

THIS DOCUMENT IS FOR THE PURPOSE OF  
 RESETTING ANY MISSING OR OBLITERATED  
 CORNERS FROM LOTS 3 & 4, AS SHOWN  
 ON BOOK 9 OF MAPS & PLATS, PAGE 35,  
 SAN JOAQUIN COUNTY RECORDS.

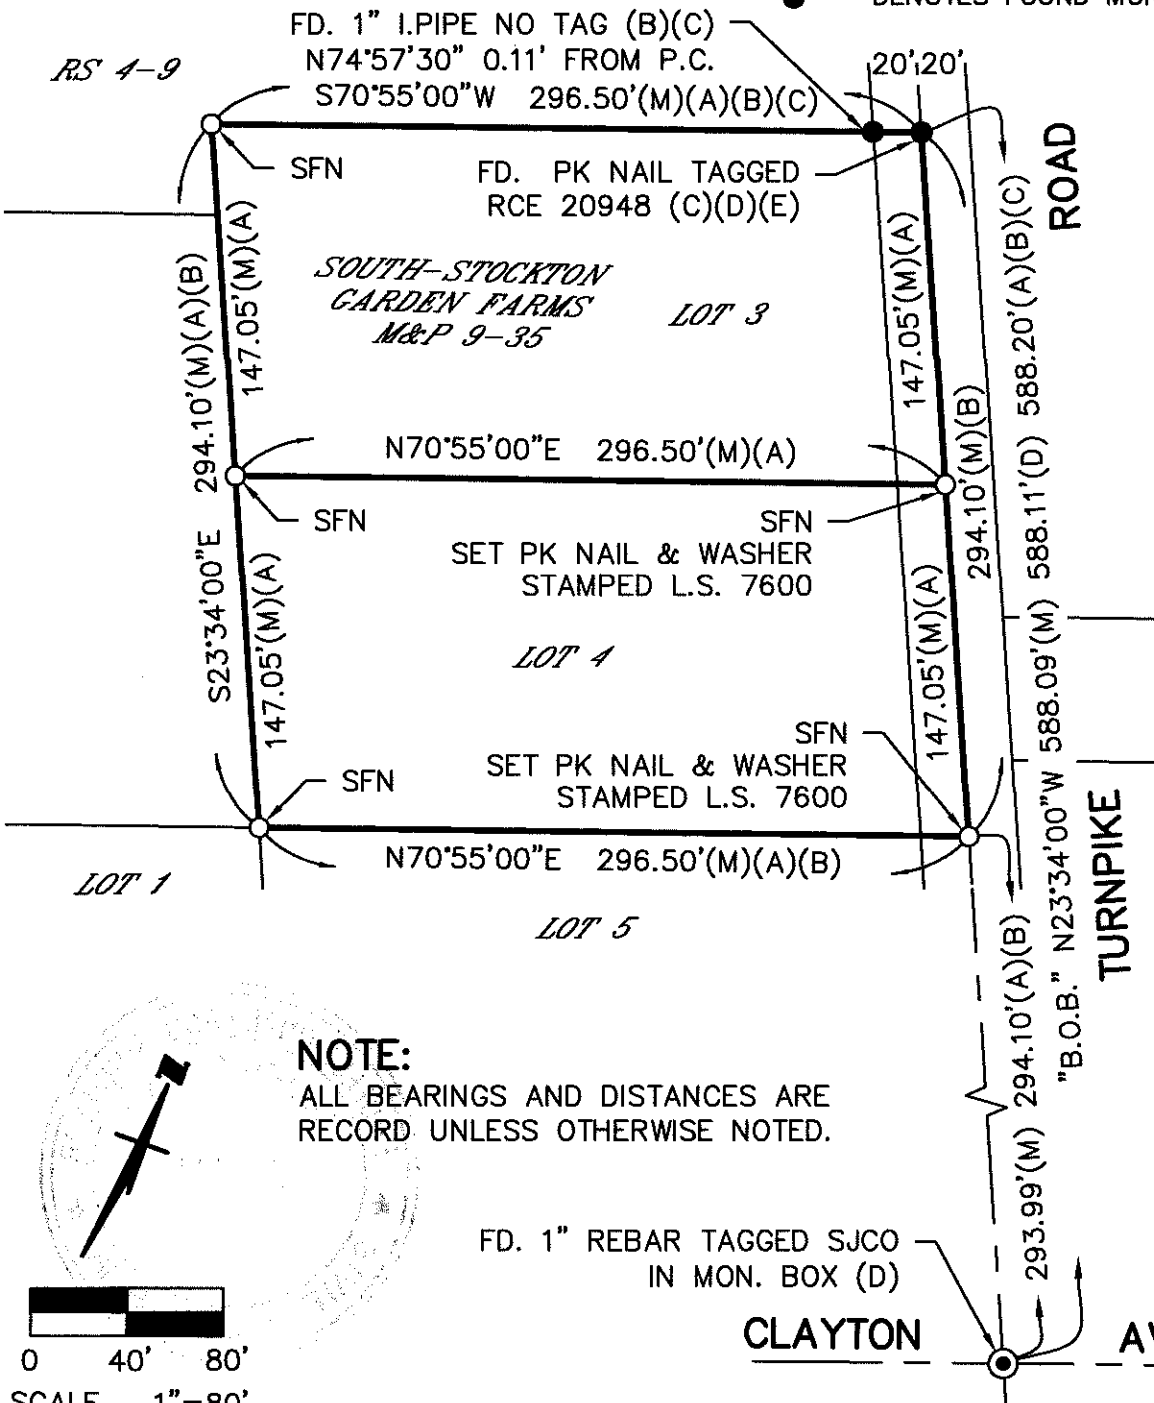


**REFERENCES:**

- (A) M&P 9-35
- (B) RS 4-9
- (C) RS 35-161
- (D) CR 11-178
- (E) CR 17-209

**NOTE:**

ALL BEARINGS AND DISTANCES ARE  
 RECORD UNLESS OTHERWISE NOTED.

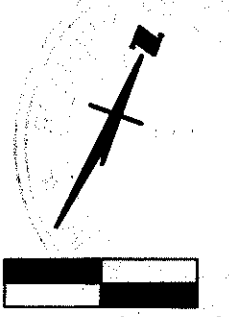

0 40' 80'  
 SCALE 1"=80'

FD. 1" REBAR TAGGED SJCO  
 IN MON. BOX (D)

**CLAYTON AVENUE**