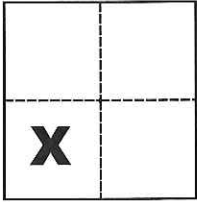


CORNER RECORD

Agency Index CR-18-110

Document Number _____

City of _____ County of San Joaquin, CaliforniaBrief Legal Description 2.000 Acre Parcel per R.S. 36-182**CORNER TYPE****COORDINATES (Optional)**

Government Corner Control
 Meander Property
 Rancho Other

N. _____ E. _____
 Elevation _____
 Units Metric U.S. Survey Foot
 Horizontal Datum _____
 Zone _____ Epoch Date _____
 Vertical Datum _____

Date of Survey April 12, 2018Sec. 18, T.2S., R.7E.,
M.D.B. & M.

Complies with Public Resources Code §§8801-8819
 Complies with Public Resources Code §§8890-8902

PLS Act Ref.: 8765(d) 8771 8773 Other:
 Corner/Monument: Left as found Established Rebuilt Pre-Construction
 Found and tagged Reestablished Referenced Post-Construction

Narrative of corner identified and monument as found, set, reset, replaced, or removed:

 See sheet #2 for description(s):**SURVEYOR'S STATEMENT**

This Corner Record was prepared by me or under my direction in conformance with

the Professional Land Surveyors' Act on May 8, 2018Signed Michael L. Quarantaro P.L.S. or R.C.E. No. L.S. 4450**COUNTY SURVEYOR'S STATEMENT**This Corner Record was received June 5, 2018and examined and filed June 5, 2018Signed James E. Hart P.L.S. or R.C.E. No. 8657Title Acting County Surveyor

County Surveyor's Comment _____



25' 25'

N89°52'46"W (A) 366.10'(A)

S00°04'32"W (A) 238.00'(A)

N00°04'32"E (A) 238.00'(A)

DOC. NO. 2018-033806

R.S. 36-182


TINNIN ROAD

S89°52'46"E (A) 366.10'(A)

166.10'(A)

200.00'(A)

25' 25'

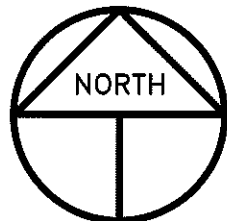


REFERENCE

(A) R.S. 36-182, S.J.C.R.

SCALE: 1" = 60'
2018-13

LEGEND

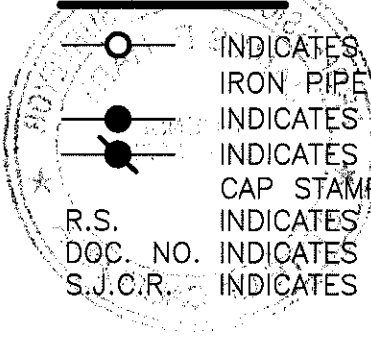

- INDICATES FOUND 3/4" IRON PIPE PER (A), BENT, REPLACED WITH 3/4" IRON PIPE W/TAG AND PLASTIC CAP STAMPED LS 4450
- INDICATES FOUND 3/4" IRON PIPE W/CAP STAMPED LS 7079 PER (A)
- INDICATES FOUND 3/4" IRON PIPE PER (A), NOT TAGGED, SET PLASTIC CAP STAMPED LS 4450
- R.S. INDICATES RECORD OF SURVEY, BOOK AND PAGE, S.J.C.R.
- DOC. NO. INDICATES DOCUMENT NUMBER, S.J.C.R.
- S.J.C.R. INDICATES SAN JOAQUIN COUNTY RECORDS