

CORNER RECORD

Agency Index CR-18-123

Document Number _____

City of TRACY

County of _____

SAN JOAQUIN, CaliforniaBrief Legal Description CORRAL HOLLOW ROAD - 25 RS 187**CORNER TYPE****COORDINATES (Optional)**

Government Corner Control

Meander Property

Rancho Other

Date of Survey APRIL 25, 2018

N. _____ E. _____

Elevation _____

Units Metric U.S. Survey Foot

Horizontal Datum _____

Zone _____ Epoch Date _____

Vertical Datum _____

 Complies with Public Resources Code §§ 8801-8819 Complies with Public Resources Code §§ 8890-8902

PLS Act Ref.:

 8765(d) 8771 8773 Other:Corner/
Monument: Left as found Established Rebuilt Pre-Construction Found and tagged Reestablished Referenced Post-Construction

Narrative of corner identified and monument as found, set, reset, replaced, or removed:

 See sheet #2 for description(s):

PRE-CONSTRUCTION DOCUMENTATION OF THE FOUND 3/4" IRON PIPE
ON THE EAST LINE OF CORRAL HOLLOW ROAD AT THE SOUTHWEST
CORNER OF PARCEL A PER 25 RS 187 WITHIN SECTION 8, T. 3 S. R 5 E. M.D.M.

SURVEYOR'S STATEMENT

This Corner Record was prepared by me or under my direction in conformance with
the Professional Land Surveyors' Act on APRIL 25, 2018

Signed _____

P.L.S. No. _____

6441**COUNTY SURVEYOR'S STATEMENT**

This Corner Record was received _____

JUNE 25, 2018

and examined and filed _____

JUNE 25, 2018

Signed _____

P.L.S. No. _____

8657Title Acting COUNTY SURVEYOR**County Surveyor's Comment**

TOWNSHIP 3 SOUTH - RANGE 5 EAST

1/2" REBAR & CAP

1/2" REBAR & CAP

1/2" REBAR & CAP

20' W

20' W

20' W

111.08'

CORRAL HOLLOW ROAD

60.71'

92.90'

18" SS

SS


SS

SS

PARCEL 'A'
25 R/S 187

FOUND 3/4" IRON PIPE
NOT TAGGED. (1" PER 25 R/S 187)

- FOUND MONUMENT AS NOTED
 - SET 1/2" REBAR & PLASTIC CAP
- R/S RECORD OF SURVEY

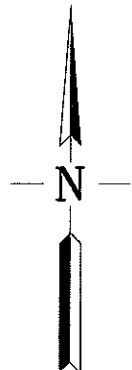

1 inch = 30 ft.