

# CORNER RECORD

Agency Index CR-18-137


Document Number \_\_\_\_\_

City of \_\_\_\_\_ County of San Joaquin, California

Brief Legal Description The South Line of the Blossom and Klien property per R.S. 2-103

### CORNER TYPE

### COORDINATES (Optional)

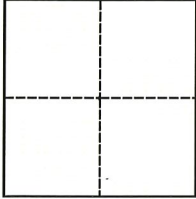

Government Corner  Control   
Meander  Property   
Rancho  Other

N. \_\_\_\_\_ E. \_\_\_\_\_  
Elevation \_\_\_\_\_  
Units Metric  U.S. Survey Foot   
Horizontal Datum \_\_\_\_\_  
Zone \_\_\_\_\_ Epoch Date \_\_\_\_\_  
Vertical Datum \_\_\_\_\_

Date of Survey November 25, 2017

Sec.'s 11 & 12, T.1S., R.4E.,  
M.D.B. & M.

Complies with Public Resources Code §§8801-8819  
 Complies with Public Resources Code §§8890-8902

PLS Act Ref.:  8765(d)  8771  8773  Other:  
Corner/Monument:  Left as found  Established  Rebuilt  Pre-Construction  
 Found and tagged  Reestablished  Referenced  Post-Construction

Narrative of corner identified and monument as found, set, reset, replaced, or removed:

See sheet #2 for description(s):

### SURVEYOR'S STATEMENT

This Corner Record was prepared by me or under my direction in conformance with

the Professional Land Surveyors' Act on July 11, 2018

Signed Michael L. Quararoli P.L.S. or R.C.E. No. L.S. 4450



### COUNTY SURVEYOR'S STATEMENT

This Corner Record was received July 27, 2018

and examined and filed July 27, 2018


Signed James E Hart P.L.S. or R.C.E. No. 8657

Title Acting County Surveyor

County Surveyor's Comment



**CAL PACK ROAD**

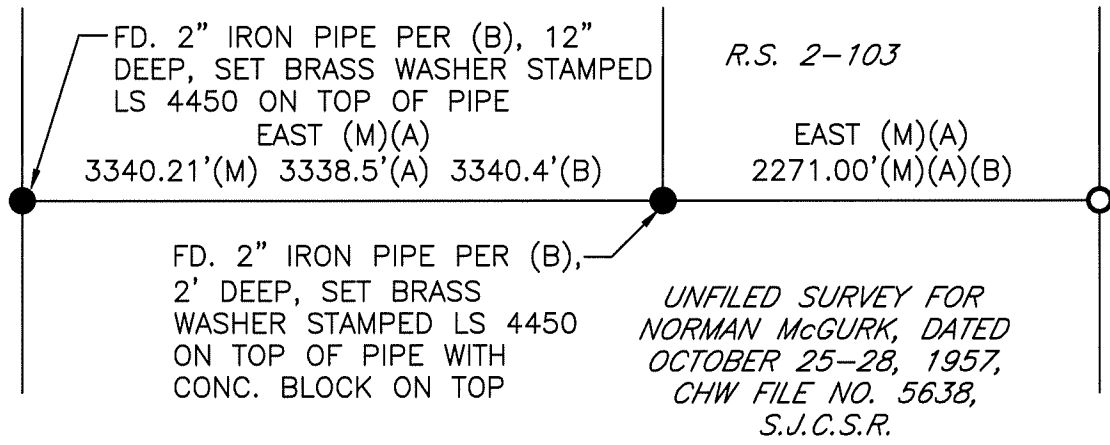


**LEGEND**

- INDICATES FOUND MONUMENT AS NOTED
- INDICATES S.F.N., SET 2" IRON PIPE TAGGED LS 4450, 12" DEEP WITH 1" BRASS DISC STAMPED LS 4450 AND AN ALUMINUM WASHER STAMPED LS 4450 ON SET ON TOP OF PIPE.
- FD. INDICATES FOUND ON THIS SURVEY
- R.S. INDICATES RECORD OF SURVEY, BOOK AND PAGE, S.J.C.R.
- S.J.C.R. INDICATES SAN JOAQUIN COUNTY RECORDS
- S.J.C.S.R. INDICATES SAN JOAQUIN COUNTY SURVEYOR'S RECORDS
- S.F.N. INDICATES SEARCHED FOUND NOTHING

**REFERENCES**

- (A) R.S. 2-103, S.J.C.R.
- (B) UNFILED SURVEY FOR NORMAN McGURK, DATED OCTOBER 25-28, 1957, CHW FILE NO. 5638, S.J.C.S.R.

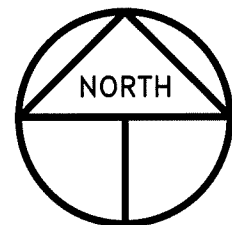

SCALE: 1" = 1000'  
2017-135 CR-2