COPN	ED DECC	ופו	Agency Index _	CR-18-145
CORNER RECORD			Document Number _	
City of		County of		
City of County of S.E. Cor. of F		Parcel "A" per P.M. 2-35		
	CORNER TYPE		COORDINATES (Optional)	
	_			E
	Government Corner	Control	Elevation	
	Meander	Property X	Units Metric	U.S. Survey Foot 🔀
	Rancho	Other	Horizontal Datum	
X			ZoneEpoch	h Date
	Date of Survey M	ay 17, 2018	Vertical Datum	
Sec. 7, T.1S., R.6E.,		Ţ		esources Code §§8801-8819
M.D.B. & M.		[Complies with Public Re	esources Code §§8890-8902
PLS Act Ref.:	8765(d)	8771	8773	Other:
Corner/	Left as found	Established	Rebuilt	Pre-Construction
Monument:	Found and tagged	Reestablished	Referenced	Post-Construction
Narrative of corner identified and monument as found, set, reset, replaced, or removed: See sheet #2 for description(s):				
SURVEYOR'S STATEMENT This Corner Record was prepared by me or under my direction in conformance with the Professional Land Surveyors' Act on P.L.S. or R.C.E. No. L.S. 4450				

COUNTY SURVEYOR'S STATEMENT

This Corner Record was received

August 6, 2018


and examined and filed


Signed

Acting County Surveyor

County Surveyor's Comment



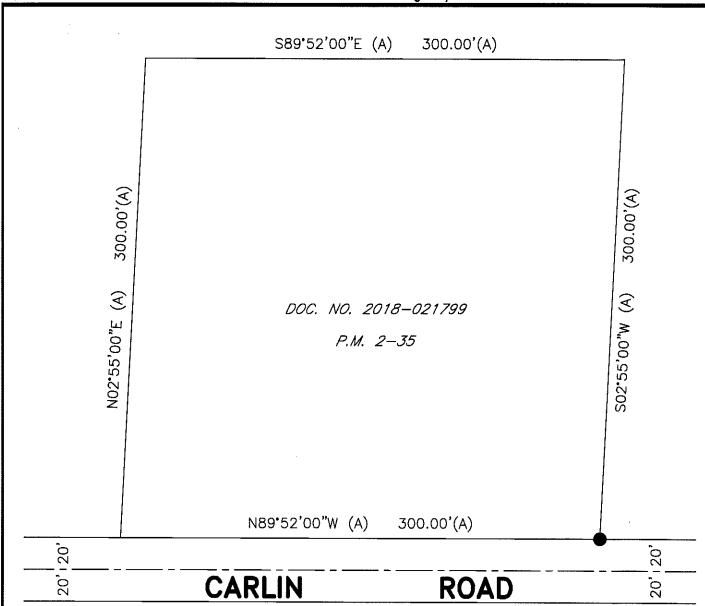

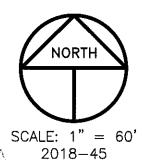

REFERENCE

(A) P.M. 2-35, S.J.C.R.

LEGEND

INDICATES FOUND 3/4" IRON PIN PER (A), SET PLASTIC CAP STAMPED LS 4450

R.M. INDICATES PARCEL MAP, BOOK AND PAGE, S.J.C.R.

DOC: NO. INDICATES DOCUMENT NUMBER, S.J.C.R. S.J.C.R. NDICATES SAN JOAQUIN COUNTY RECORDS