

CORNER RECORD


Agency Index CR-18-150

Document Number _____

City of STOCKTON

County of SAN JOAQUIN, California

Brief Legal Description MONUMENT PRESERVATION FOR A PORTION OF MICHAEL AVE., RALPH AVE., CARPENTER RD., BELLEVIEW ST., VOLNEY ST. AND PHELPS ST..

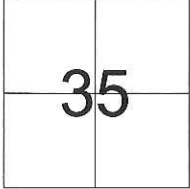

CORNER TYPE

- Government Corner Control
- Meander Property
- Rancho Other

COORDINATES (Optional)

N. _____ E. _____

Elevation _____

Units Metric U.S. Survey Foot

Horizontal Datum NAD 83

Zone III Epoch Date 1991.35

Vertical Datum _____

Complies with Public Resources Code §§8801-8819

Complies with Public Resources Code §§8890-8902

C.M. WEBER GRANT

Date of Survey MARCH 14, 2018

PLS Act Ref: 8765(d) 8771 8773 Other: _____

Corner/Monument: Left as found Established Rebuilt Pre-Construction

Found and tagged Reestablished Referenced Post-Construction

Narrative of corner identified and monument as found, set, reset, replaced, or removed:
 See sheet #2 for description(s) :

SURVEYOR'S STATEMENT

This Corner Record was prepared by me or under my direction in conformance with
the Professional Land Surveyors' Act on APRIL 10, 2018.

Signed [Signature] P.L.S. or R.C.E. No. 7051



COUNTY SURVEYOR'S STATEMENT

This Corner Record was received August 15, 2018
and examined and filed August 15, 2018.

Signed [Signature] P.L.S. or R.C.E. No. 8657

Title Acting County Surveyor

County Surveyor's Comment _____




DATUM STATEMENT:

COORDINATES SHOWN HEREON ARE GRID AND ARE BASED ON CITY OF STOCKTON MONUMENTS 119, 176 AND 1006 CALIFORNIA COORDINATE SYSTEM (CCS83), ZONE III, 1983 NAD, (1991.35 EPOCH STOCKTON & SAN JOAQUIN COUNTY GPS ADJUSTMENT) AS SHOWN ON RECORD OF SURVEY BOOK 35 OF SURVEYS, PAGE 05.

STATEMENT OF PURPOSE:

THE PURPOSE OF THIS SURVEY IS TO IDENTIFY AND RECORD THE POSITION OF EXISTING MONUMENTS PRIOR TO PG&E IMPROVEMENTS. NO CLAIM IS MADE AS TO THE RELATIONSHIP OF THE MONUMENTS SHOWN HEREON TO RECORDED PROPERTY LINES OR RIGHT OF WAY. LOT LINES AND RIGHT OF WAY SHOWN ARE FOR GENERAL LOCATION AND INFORMATIONAL PURPOSES ONLY.

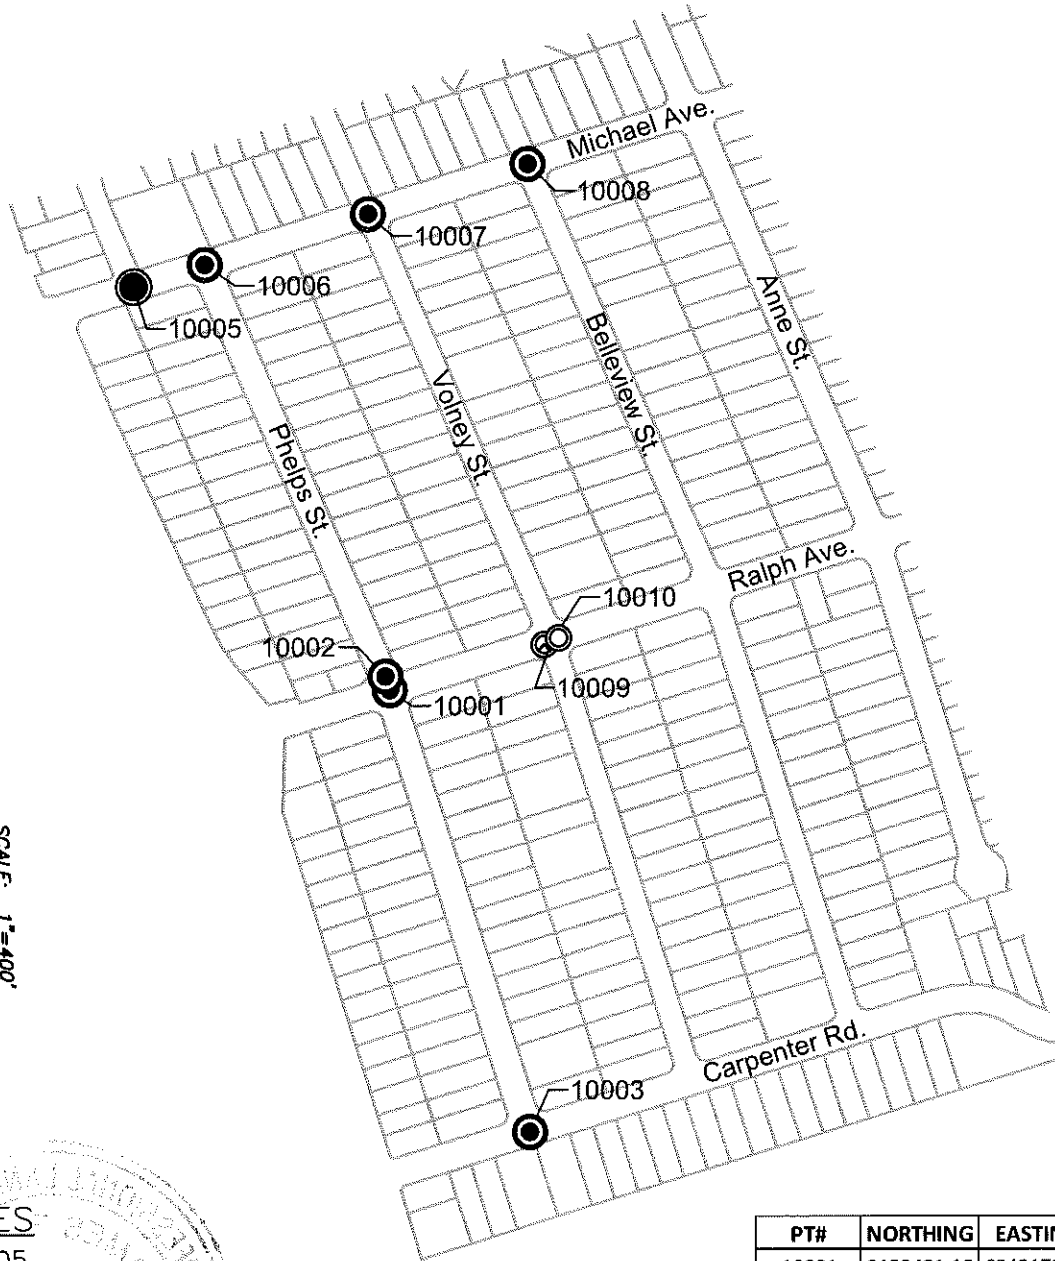

SCALE: 1"=400'

REFERENCES

35 SURVEYS 05

LEGEND:

- INDICATES FOUND PK NAIL, NO RECORD.
- ⊙ INDICATES FOUND MAG NAIL & SHINER, NO RECORD.
- INDICATES FOUND 3/4" REBAR & CAP LS 4334 IN MONUMENT WELL. NO RECORD
- ⦿ INDICATES FOUND 5/8" IRON ROD IN MONUMENT WELL, NO RECORD.

PT#	NORTHING	EASTING	ELEV.
10001	2158481.16	6342173.84	18.51
10002	2158509.67	6342164.81	18.23
10003	2157559.90	6342465.37	18.15
10004	2158853.78	6342015.34	19.04
10005	2159322.77	6341643.15	18.71
10006	2159368.68	6341791.50	18.71
10007	2159473.79	6342131.07	18.87
10008	2159577.50	6342465.88	18.92
10009	2158586.20	6342513.71	19.06
10010	2158586.97	6342516.26	19.03