


# CORNER RECORD

Agency Index CR-18-153  
Document Number \_\_\_\_\_

City of Tracy County of San Joaquin, California  
Brief Legal Description Monument East of MacArthur, Northeasterly Corner of Lot 24 per 10-M-44.

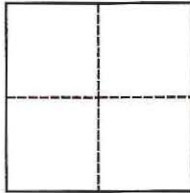

### CORNER TYPE

### COORDINATES (Optional)

Government Corner  Control  Elevation \_\_\_\_\_ N. \_\_\_\_\_ E. \_\_\_\_\_  
 Meander  Property  Units \_\_\_\_\_ Metric  U.S. Survey Foot   
 Rancho  Other  Horizontal Datum \_\_\_\_\_  
 Date of Survey April 30, 2018 Zone \_\_\_\_\_ Epoch Date \_\_\_\_\_  
 Vertical Datum \_\_\_\_\_  
 Complies with Public Resources Code §§8801-8819  
 Complies with Public Resources Code §§8890-8902

PLS Act Ref.:  8765(d)  8771  8773  Other:  
 Corner/Monument:  Left as found  Established  Rebuilt  Pre-Construction  
 Found and tagged  Reestablished  Referenced  Post-Construction


Narrative of corner identified and monument as found, set, reset, replaced, or removed:  
 See sheet #2 for description(s):

Set 2" brass disk with punch inside monument well.

### SURVEYOR'S STATEMENT

This Corner Record was prepared by me or under my direction in conformance with  
 the Professional Land Surveyors' Act on May 2, 2018

Signed [Signature] P.L.S. or R.C.E. No. 8654

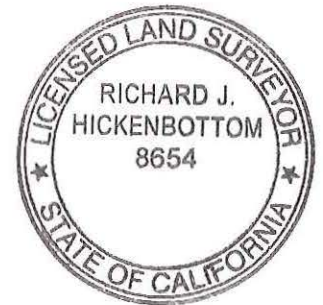

### COUNTY SURVEYOR'S STATEMENT

This Corner Record was received August 24, 2018  
 and examined and filed August 24, 2018

Signed James E. Hart P.L.S. or R.C.E. No. 8657

Title Acting County Surveyor

County Surveyor's Comment



**LEGEND**

- ✕ FOUND NAIL W/ TAG "LS8654" PER CR-17-132
- FOUND IRON PIPE W/ PLUG "LS8654" PER CR-17-132
- ⊙ SET 2" BRASS DISK IN MONUMENT WELL
- PP POWER POLE
- SFNF SEARCHED FOR NOT FOUND
- TB TELEPHONE BOX
- EDGE OF PAVEMENT
- CENTERLINE
- BOUNDARY LINE
- MONUMENT TIE LINE
- TOP OF BANK

**LOT 24**  
 MAP OF UNIT NO. 1  
 PESCADERO COLONY  
 10 M 44

**LOT 37**  
 MAP OF UNIT NO. 1  
 PESCADERO COLONY  
 10 M 44

