


# CORNER RECORD

Agency Index CR-18-156

Document Number \_\_\_\_\_

City of Tracy County of San Joaquin, California

Brief Legal Description Monument at intersection of MacArthur Drive and Arbor Avenue.

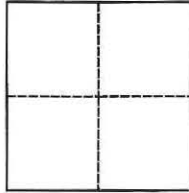

### CORNER TYPE

Government Corner  Control   
Meander  Property   
Rancho  Other

Date of Survey April 30, 2018

### COORDINATES (Optional)

N. \_\_\_\_\_ E. \_\_\_\_\_

Elevation \_\_\_\_\_

Units Metric  U.S. Survey Foot

Horizontal Datum \_\_\_\_\_

Zone \_\_\_\_\_ Epoch Date \_\_\_\_\_

Vertical Datum \_\_\_\_\_

Complies with Public Resources Code §§8801-8819

Complies with Public Resources Code §§8890-8902

PLS Act Ref.:  8765(d)  8771  8773  Other:

Corner/Monument:  Left as found  Established  Rebuilt  Pre-Construction

Found and tagged  Reestablished  Referenced  Post-Construction

Narrative of corner identified and monument as found, set, reset, replaced, or removed:

See sheet #2 for description(s):


Set 2" brass disk with punch inside monument well.

### SURVEYOR'S STATEMENT

This Corner Record was prepared by me or under my direction in conformance with

the Professional Land Surveyors' Act on May 2, 2018

Signed [Signature] P.L.S. or R.C.E. No. 8654

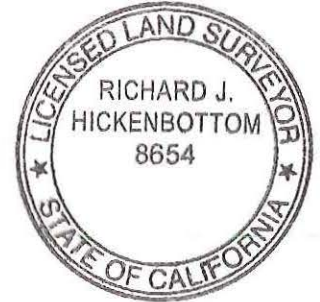

### COUNTY SURVEYOR'S STATEMENT

This Corner Record was received August 24, 2018

and examined and filed August 24, 2018

Signed [Signature] P.L.S. or R.C.E. No. 8657

Title Acting County Surveyor

County Surveyor's Comment



**LEGEND**

- ✕ FOUND NAIL W/ TAG "LS8654" PER CR-17-133
- FOUND IRON PIPE W/ PLUG "LS8654" PER CR-17-133
- ⊙ SET 2" BRASS DISK IN MONUMENT WELL
- PP POWER POLE
- GLM GAS LINE MARKER
- TB TELEPHONE BOX
- EDGE OF PAVEMENT



Scale 1" = 30'

