


CORNER RECORD

Agency Index CR-18-162
Document Number _____

City of Lodi County of San Joaquin, California
Brief Legal Description Center of the intersection of Harney Lane and S. Hutchins Street

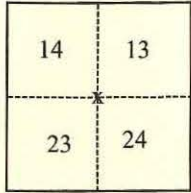

T3N,R6E,MDM

CORNER TYPE

- Government Corner
- Meander
- Rancho
- Control
- Property
- Other

Date of Survey May 30, 2018

COORDINATES (Optional)

- N. _____ E. _____
Elevation _____
Units Metric U.S. Survey Foot
Horizontal Datum _____
Zone _____ Epoch Date _____
Vertical Datum _____
 Complies with Public Resources Code §§8801-8819
 Complies with Public Resources Code §§8890-8902

- PLS Act Ref.: 8765(d) 8771 8773 Other:
Corner/Monument: Left as found Established Rebuilt Pre-Construction
 Found and tagged Reestablished Referenced Post-Construction

Narrative of corner identified and monument as found, set, reset, replaced, or removed:

See sheet #2 for description(s):

SURVEYOR'S STATEMENT


This Corner Record was prepared by me or under my direction in conformance with
the Professional Land Surveyors' Act on July 17, 2018
Signed *Michael L. Foulk* P.L.S. or R.C.E. No. P.L.S. 7803



COUNTY SURVEYOR'S STATEMENT

This Corner Record was received September 21, 2018
and examined and filed September 21, 2018
Signed *James E. Hart* P.L.S. or R.C.E. No. 8657
Title Acting County Surveyor
County Surveyor's Comment _____



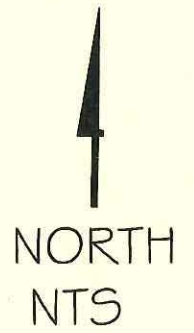

S. HUTCHINS STREET

SCRIBED "X" ON CONCRETE

SCRIBED "X" ON CONCRETE

HARNEY LANE

2.5" BRASS DISC
STAMPED L57803
IN MONUMENT WELL

SCRIBED "X" ON CONCRETE

COTTON SPINDLE

WEST LANE

LEGEND

 SET MONUMENT AS NOTED

 FOUND REFERENCE POINTS AS SHOWN
ON CR-17-189

N 40° 05' 58" W
81.60'

N 36° 13' 16" E
72.27'

S 30° 45' 29" W
154.53'

S 51° 09' 41" W
80.93'