
| CORN City of | IER REC | | Document Number | <u>R- 8- 75</u> n, California |
|--|---|--|--------------------------------------|--|
| Brief Legal Description | | | er P.M. 2-167, S.J.C.F | |
| CORN | | IER TYPE | | |
| X 2 7 25 P 65 | Government Corner Meander Rancho Date of Survey | Control Property Other July 10, 2018 | Horizontal DatumEpoch Vertical Datum | U.S. Survey Foot X |
| Sec. 3, T.2S., R.6E., M.D.B. & M. | | | Complies with Public Res | sources Code §§8890-8902 |
| PLS Act Ref.: | 8765(d) | 8771 | 8773 | Other: |
| Corner/ Monument: | Left as found Found and tagged | Established Reestablished | Rebuilt Referenced | Pre-Construction Post-Construction |
| Narrative of corner identifie See sheet #2 for descr This Corner Record was pr the Professional Land Surv Signed | SURVEYOR'S ST epared by me or under re | ATEMENT my direction in conforma A 2 1 2 P.L.S. or R.C.E. No. | nce with | No. 4450 CALIFORNIA A CONTROL OF CALIFORNIA |
| | <u> </u> | A CONTRACTOR OF THE STATE OF TH | | |
| This Corner Record was reand examined and filed Signed | November 1 | 6, 2018 P.L.S. or R.C.E . No. | 8657 | ES ALLS E. HAP SUPERIOR EN LICENSE |

County Surveyor's Comment

Acting County Surveyor

Title

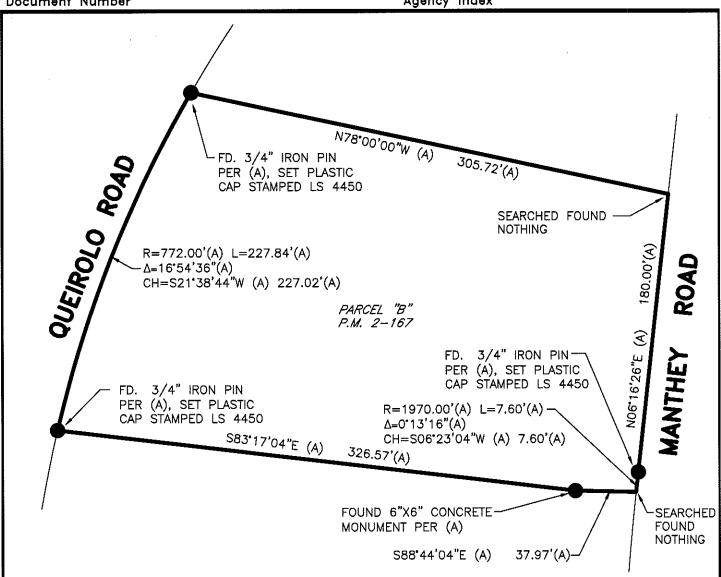

LEGEND

P.M. S.J.C.R.

INDICATES FOUND MONUMENTS AS NOTED INDICATES PARCEL MAP, BOOK AND PAGE, S.J.C.R. INDICATES SAN JOAQUIN COUNTY RECORDS

REFERENCE

(A) P.M. 2-167, S.J.C.R.



SCALE: 1" = 60'2018-151