


CORNER RECORD

Agency Index CR-18-184
Document Number _____

City of STOCKTON County of SAN JOAQUIN, California
Brief Legal Description PARCEL 2 PER P.M. 21-198, PORTION OF SEC. 29, C.M. WEBER GRANT

CORNER TYPE

COORDINATES (Optional)

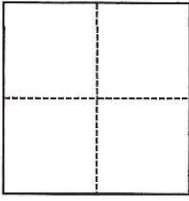

- Government Corner
- Meander
- Rancho
- Control
- Property
- Other

N. _____ E. _____
 Elevation _____
 Units Metric U.S. Survey Foot
 Horizontal Datum _____
 Zone _____ Epoch Date _____
 Vertical Datum _____
 Complies with Public Resources Code §§8801-8819
 Complies with Public Resources Code §§8890-8902

Date of Survey OCTOBER 23, 2018

- PLS Act Ref.: 8765(d) 8771 8773 Other:
- Corner/Monument: Left as found Established Rebuilt Pre-Construction
 Found and tagged Reestablished Referenced Post-Construction

Narrative of corner identified and monument as found, set, reset, replaced, or removed:
 See sheet #2 for description(s):

SET MISSING CORNER AND RESET CORNERS OBLITERATED BY CONSTRUCTION.

SURVEYOR'S STATEMENT

This Corner Record was prepared by me or under my direction in conformance with
the Professional Land Surveyors' Act on NOVEMBER 27, 2018

Signed *J.C.W.* P.L.S. or R.C.E. No. 7600



COUNTY SURVEYOR'S STATEMENT

This Corner Record was received November 27, 2018
and examined and filed December 13, 2018

Signed *James E. Hart* P.L.S. or R.C.E. No. 8657
Title Acting County Surveyor

County Surveyor's Comment _____






WONG ENGINEERS, INC.
 PLANNING ENGINEERING SURVEYING
 4578 FEATHER RIVER DRIVE, SUITE A
 STOCKTON, CALIFORNIA (209) 476-0011
 OCTOBER 24, 2018


DESCRIPTION:

THIS DOCUMENT IS FOR THE PURPOSE OF RESETTING ANY MISSING OR OBLITERATED CORNERS FROM PARCEL 2, AS SHOWN ON BOOK 21 OF PARCEL MAPS, PAGE 198, SAN JOAQUIN COUNTY RECORDS.

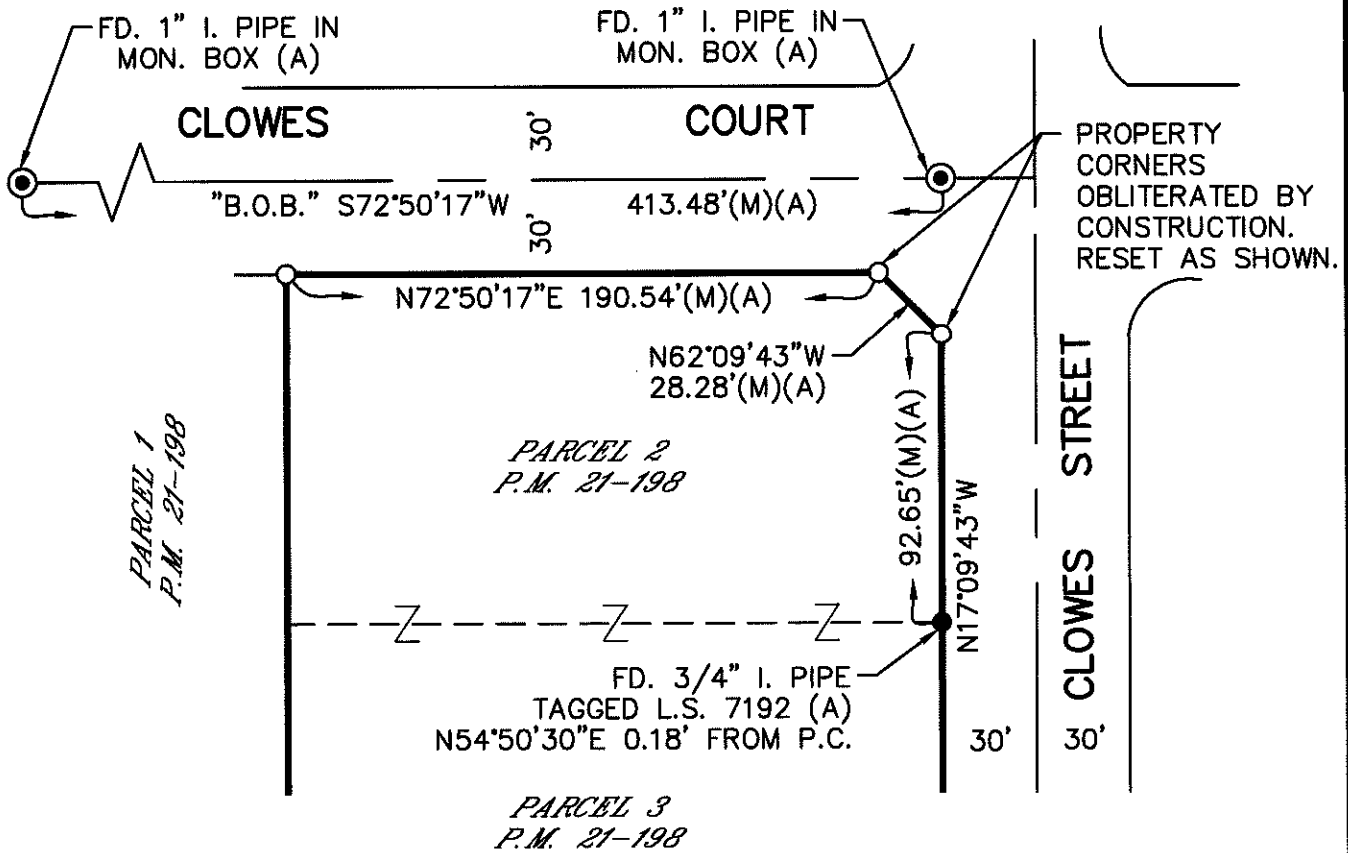

LEGEND:

- B.O.B. DENOTES BASIS OF BEARINGS
- FD. DENOTES FOUND
- I. DENOTES IRON
- M DENOTES MEASURED
- MON. DENOTES MONUMENT
- P.C. DENOTES PROPERTY CORNER
- P.M. DENOTES PARCEL MAP
- DENOTES SET 3/4" X 30" I.PIN TAGGED L.S. 7600, UNLESS OTHERWISE NOTED
- ⊙ DENOTES MONUMENT BOX
- DENOTES FOUND MONUMENT AS NOTED
- Z-- DENOTES MERGED LINES

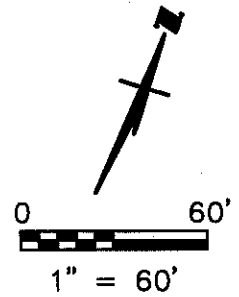

REFERENCE:
 (A) P.M. 21-198