CORN	IER REC	ORD	Agency Index Document Number	CR-19-05
			San Joaqu	
Brief Legal Descriptior	1 PO	rtion of C.IVI. vve	ber Grant Line per R	.5. 35-39
С		TYPE	COORDINATES (Optional)	
Sec. 5, T.1S., R.7E., M.D.B. & M.	Government Corner Meander Rancho Date of Survey Nov	Control Property Other /ember 7, 2018		U.S. Survey Foot 🗵
PLS Act Ref.:	8765(d)	8771	X 8773	Other:
Corner/ Wonument:	Left as found	Established Reestablished	Rebuilt	Pre-Construction

SURVEYOR'S STATEMENT

This Corner Record was prepared by me or under my direction in conformance with

Narrative of corner identified and monument as found, set, reset, replaced, or removed:

the Professional Land Surveyors' Act on

See sheet #2 for description(s):



COUNTY SURVEYOR'S STATEMENT

This Corner Record was received

January 8, 2019

and examined and filed

Signed


Title

January 17, 2019

Hant P.L.S. OFR.C.E. No. 8657

Acting County Surveyor

County Surveyor's Comment

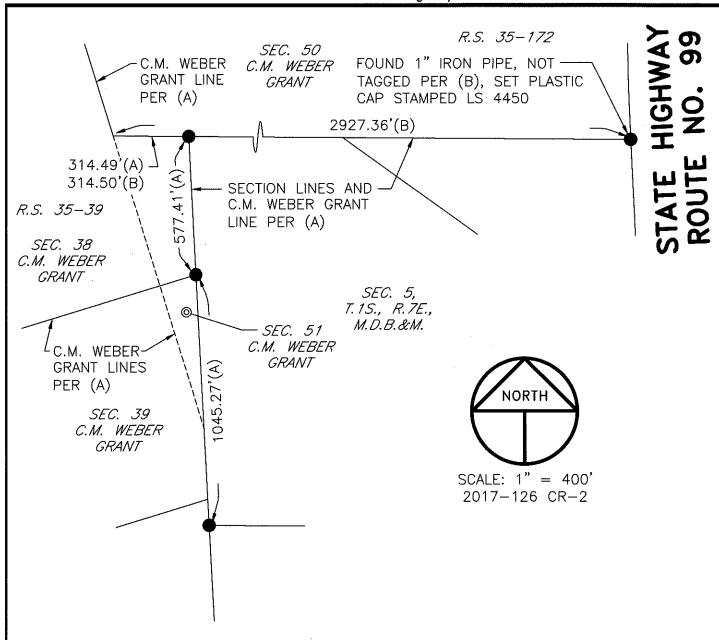

REFERENCES

(A) R.S. 35-39, S.J.C.R.

(B) R.S. 35-172, S.J.C.R.

LEGEND

INDICATES FOUND 1" IRON PIPE, NOT TAGGED PER (A), SET PLASTIC CAP

STAMPED LS 4450, UNLESS OTHERWISE NOTED

R.S. INDICATES RECORD OF SURVEY, BOOK AND PAGE, S.J.C.R.

S.J.C.R. INDICATES SAN JOAQUIN COUNTY RECORDS