
CORNER RECORD Agency Index: Document Number: City of STOCKTON SAN JOAQUIN County of ____ , California Brief Legal Description PORTION OF BLOCK 104 OF "EAST OF CENTER STREET", SECTION 19 OF THE C.M. WEBER GRANT CORNER TYPE COORDINATES (Optional) Government Corner Control Elevation Property Meander ☐ Metric U.S. Survey Foot Units Rancho · Other Horizontal Datum Zone _____ Epoch Date __ Date of Survey 01-29-2019 Vertical Datum Complies with Public Resources Code S§8801-8819 Complies with Public Resources Code S\$8890-8902 X 8765(d) **X** 8771 PLS Act Ref: 8773 Other: Left as found Established Corner/ Rebuilt Pre-Construction Monument: Found and Tagged **X** Reestablished Referenced ▼ Post-Construction Narrative of corner identified and monument as found, set, reset, replaced, or removed: See sheet #2 for description(s): ORIGINAL MONUMENTS PER 38-S-192 DESTROYED BY CONSTRUCTION; NE CORNER FALLS IN CONCRETE FOOTING OF WALL; SE CORNER FALLS IN SIDEWALK RETURN; SET NAIL AND BRASS TAG, STAMPED "LS 6946" AT BOTH LOCATIONS. SURVEYOR'S STATEMENT This Corner Record was prepared by me or under my direction in conformance with the Land Surveyors' Act on _ JANUARY 29 2019 GROENEWOU Signed . COUNTY SURVEYOR'S STATEMENT This Corner Record was received February 25, 2019 and examined and filed _ County Surveyor's Comment _____

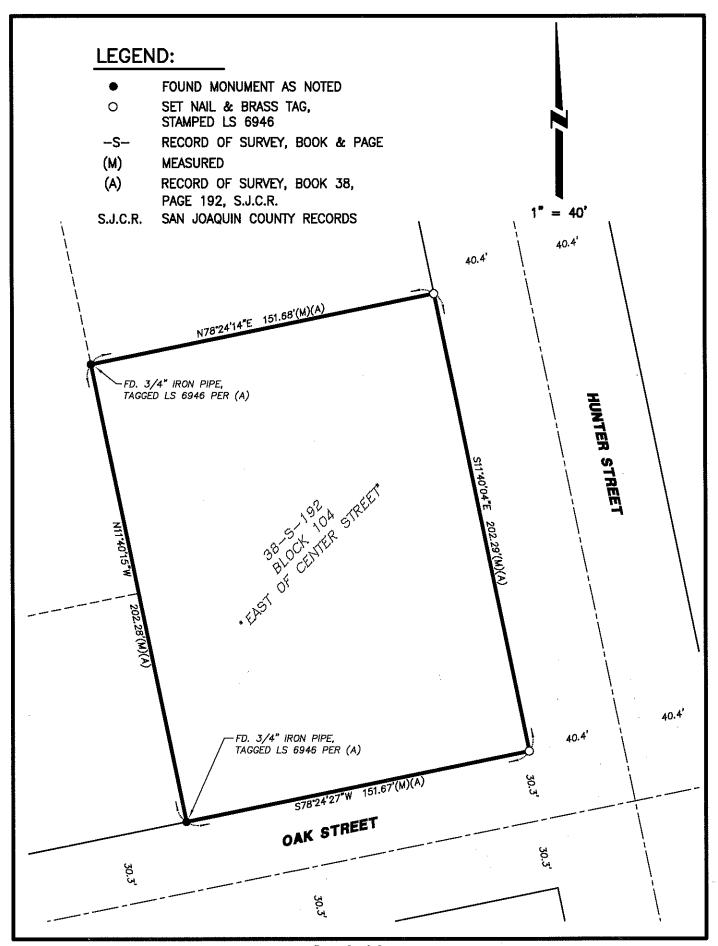

Page 2 of 2