


CORNER RECORD

Agency Index: CR-19-27

Document Number: _____

City of MANTECA County of SAN JOAQUIN, California

Brief Legal Description MONUMENTS LOCATED IN THE NORTHEAST QUARTER OF SECTION 5, T.2S, R.7E, M.D.B.&M.

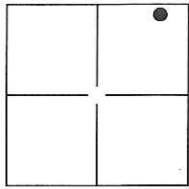

SEC. 5
T.2S, R.7E

CORNER TYPE

Government Corner Control
 Meander Property
 Rancho Other

Date of Survey 01-28-2019

COORDINATES (Optional)

N. _____ E. _____

Elevation: _____

Units Metric U.S. Survey Foot

Horizontal Datum: _____

Zone: _____ Epoch Date: _____

Vert. Datum: _____

Complies with Public Resources Code SS8801-8819

Complies with Public Resources Code SS8890-8902

PLS Act Ref: 8765(d) 8771 8773 Other: _____

Corner/
Monument: Left as found Established Rebuilt Pre-Construction
 Found and Tagged Reestablished Referenced Post-Construction

Narrative of corner identified and monument as found, set, reset, replaced, or removed:

See sheet #2 for description(s):

SEE PAGE 2 FOR MONUMENT DESCRIPTIONS

SET FOUR (4) CONCRETE NAILS WITH BRASS TAGS "LS 6953" AS WITNESS CORNERS, AS SHOWN ON PAGE 2.


SURVEYOR'S STATEMENT

This Corner Record was prepared by me or under my direction in conformance with
 the Land Surveyors' Act on JANUARY 31, 2019,
 Signed [Signature] P.L.S. or R.C.E. Number 6953



COUNTY SURVEYOR'S STATEMENT

This Corner Record was received March 11, 2019
 and examined and filed March 26, 2019
 Signed James E. Hart P.L.S. or R.C.E. No: 8657
 Title County Surveyor

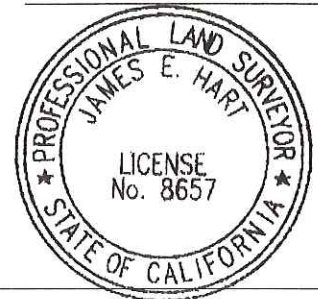

County Surveyor's Comment _____

LEGEND:

- ⊗ SET MONUMENT AS NOTED.
- FOUND MONUMENT AS NOTED.
- (M) MEASURED DISTANCE. ALL DISTANCES ARE MEASURED UNLESS NOTED OTHERWISE.
- RS DENOTES RECORD OF SURVEY
- S.J.C.R. SAN JOAQUIN COUNTY RECORDS

X AND DISTANCE TABLE		
BS-@-FS	X	FS DISTANCE
B-A-B	00°00'00"	178.99'(M)
B-A-C	180°00'00"	72.58'(M)
B-A-D	104°22'32"	373.99'(M)
B-A-E	00°00'00"	115.08'(M)
B-A-F	104°22'32"	402.79'(M)



NOT TO SCALE

REFERENCE:

(R1) 33-RS-196, S.J.C.R.

