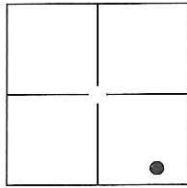


# CORNER RECORD

Agency Index: CR-19-28

Document Number: \_\_\_\_\_

City of MANTECA County of SAN JOAQUIN, CaliforniaBrief Legal Description MONUMENT LOCATED IN THE SOUTHEAST QUARTER OF SECTION 32, T.1S, R.7E, M.D.B.&M.SEC. 32  
T.1S, R.7E**CORNER TYPE**
 Government Corner  Control   
 Meander  Property   
 Rancho  Other 
Date of Survey 01-28-2019**COORDINATES (Optional)**

N. \_\_\_\_\_ E. \_\_\_\_\_

Elevation: \_\_\_\_\_

Units Metric  U.S. Survey Foot 

Horizontal Datum: \_\_\_\_\_

Zone: \_\_\_\_\_ Epoch Date: \_\_\_\_\_

Vert. Datum: \_\_\_\_\_


 Complies with Public Resources Code SS8801-8819  
 Complies with Public Resources Code SS8890-8902
PLS Act Ref:  8765(d)  8771  8773  Other: \_\_\_\_\_
 Corner/Monument:  Left as found  Established  Rebuilt  Pre-Construction  
 Found and Tagged  Reestablished  Referenced  Post-Construction

Narrative of corner identified and monument as found, set, reset, replaced, or removed:

 See sheet #2 for description(s):

FOUND A CUT "X" AT THE BACK OF SIDEWALK NEAR THE SOUTHWEST CORNER OF PARCEL "B" AS SHOWN ON THAT PARCEL MAP FILED FOR RECORD IN BOOK 11 OF PARCEL MAPS AT PAGE 109, S.J.C.R., LOCATED IN THE SOUTHEAST QUARTER OF SECTION 32, T.1S, R.7E, M.D.B.&M.

SET THREE (3) CONCRETE NAILS WITH BRASS TAGS "LS 6953" AS WITNESS CORNERS, AS SHOWN ON PAGE 2.

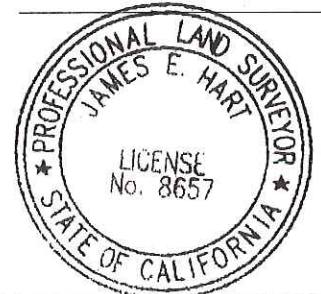**SURVEYOR'S STATEMENT**
 This Corner Record was prepared by me or under my direction in conformance with the Land Surveyors' Act on JANUARY 31, 2019,  
 Signed [Signature] P.L.S. or R.C.E. Number 6953
**COUNTY SURVEYOR'S STATEMENT**
 This Corner Record was received March 11, 2019  
 and examined and filed March 26, 2019  
 Signed James E. Hart P.L.S. or R.C.E. No: 8657  
 Title County Surveyor  
 County Surveyor's Comment \_\_\_\_\_


**LEGEND:**

- ⊗ SET MONUMENT AS NOTED.
- FOUND MONUMENT AS NOTED.
- (M) MEASURED DISTANCE. ALL DISTANCES ARE MEASURED UNLESS NOTED OTHERWISE.
- PM DENOTES PARCEL MAP
- S.J.C.R. SAN JOAQUIN COUNTY RECORDS

X AND DISTANCE TABLE		
BS-@-FS	X	FS DISTANCE
B-A-B	00°00'00"	146.90'(M)
B-A-C	00°00'00"	78.46'(M)
B-A-D	00°00'00"	28.48'(M)
B-A-E	180°00'00"	180.97'(M)



NOT TO SCALE

**REFERENCE:**

(R1) 011-PM-109, S.J.C.R.

