

CORNER RECORD


Agency Index CR-19-41
 Document Number _____

City of LATHROP County of SAN JOAQUIN, California

Brief Legal Description LOT 6 OF TRACT NO. 2529 RECORDED IN BOOK 31 OF MAPS AND PLATS, PAGE 85, SAN JOAQUIN COUNTY RECORDS, SECTION 34, TOWNSHIP 1 SOUTH, RANGE 6 EAST, M.D.B.&M

CORNER TYPE

COORDINATES (Optional)

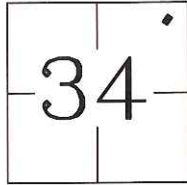

Government Corner Control
 Meander Property
 Rancho Other

N. _____ E. _____
 Elevation _____
 Units Metric U.S. Survey Foot
 Horizontal Datum _____
 Zone _____ Epoch Date _____
 Vertical Datum _____

Date of Survey 1-13-2017

Complies with Public Resources Code §§8801-8819
 Complies with Public Resources Code §§8890-8902

PLS Act Ref.: 8765(d) 8771 8773 Other
 Corner/Monument: Left as found Established Rebuilt Pre-Construction
 Found and tagged Reestablished Referenced Post-Construction

Narrative of corner identified and monument as found, set, reset, replaced, or removed:

See sheet #2 for description(s):

SEE SHEET 2 FOR LOCATION AND DESCRIPTION OF FOUND MONUMENTS

SURVEYOR'S STATEMENT

This Corner Record was prepared by me or under my direction in conformance with the Professional Land Surveyor's Act on MARCH 15, 2018.

Signed [Signature] P.L.S. 5277




COUNTY SURVEYOR'S STATEMENT

This corner record was received April 16, 2019
 and examined and filed May 2, 2019.

Signed James E Hart P.L.S. or R.O.E. No. 8657
 Title County Surveyor



County Surveyor's Comment

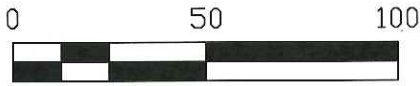

FOUND 3/4" IP
DOWN 5"
TAGGED RCE 24029

FOUND 3/4" IP
DOWN 3"
TAGGED RCE 24029

LOUISE AVENUE

N:5101.86
E:4973.20

N:5099.46
E:5268.33

LEGEND

- FOUND MONUMENT AS NOTED
- ⊗ CONTROL POINT
- ⊕ SANITARY SEWER CLEAN OUT
- ⊙ SANITARY SEWER MANHOLE
- STORM DRAIN GRATE
- STORM DRAIN GRATE
- IP IRON PIPE
- () RECORD DATA AS SHOWN ON TRACT NO. 2529

FOUND TAG RCE 24029
FLUSH ON CURB

N:5048.57
E:5406.97

FOUND X ON CONCRETE

N:5032.69
E:5338.83

N:4946.10
E:5127.38

SET X ON CURB
JANUARY 13, 2017

(N 89°32'30" W)
(218.71')

FOUND 3/4" IP
DOWN 6"
TAGGED RCE 24029

N:4927.66
E:5333.68

(N 14°27'06" E)
(76.60')

LOT 6 OF TRACT NO. 2529
RECORDED IN BOOK 31 OF MAPS AND
PLATS, PAGE 85, SAN JOAQUIN COUNTY
RECORDS

(A165.56'
R396.00'
D23°57'15")

(N 50°25'57" W)
(190.05')

FOUND 3/4" IP
DOWN 10"
NO TAG

N:4775.37
E:5272.85

(A50.95'
R500.00'
D5°50'17")

FOUND 3/4" IP
DOWN 10"
TAGGED RCE 24029

N:4734.28
E:5242.32

FOUND 3/4" IP
DOWN 10"
TAGGED RCE 24029

N:4602.63
E:5074.29

HARLAN ROAD

SET X ON CURB
JANUARY 13, 2017

N:4696.50
E:5335.19

