CR-19-48 CORNER RECORD Agency Index **Document Number** City of _____ City of Manteca ___ County of ____ San Joaquin ___ , California Brief Legal Description Chiseled crosses along the Westerly right-of-way line of Main Street as shown on P.M. 3-57, S.J.C.R. **CORNER TYPE COORDINATES (Optional)** E. Government Corner Control Elevation U.S. Survey Foot Meander Property Units Metric Rancho Other Horizontal Datum X Zone Epoch Date Date of Survey January 5, 2019 Vertical Datum Complies with Public Resources Code §§8801-8819 Sec. 29, T.1S., R.7E., Complies with Public Resources Code §§8890-8902 M.D.B. & M. PLS Act Ref.: 8765(d) 8771 8773 Other: Left as found Established Rebuilt Pre-Construction Corner/ Monument: Found and tagged Reestablished Referenced Post-Construction Narrative of corner identified and monument as found, set, reset, replaced, or removed: ✓ See sheet #2 for description(s):

SURVEYOR'S STATEMENT

This Corner Record was prepared by me or under my direction in conformance with

the Professional Land Surveyors' Act on



COUNTY SURVEYOR'S STATEMENT

This Corner Record was received

and examined and filed

Signed Title


County Surveyor's Comment




Job No.: 2009-84 Main 1

NORTHGATE

DRIVE

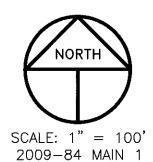

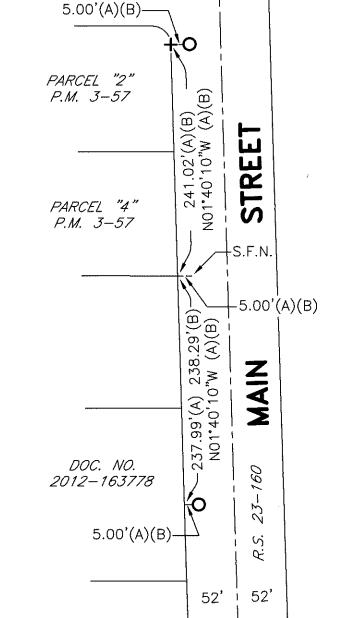

REFERENCES

(A) R.S. 23-160, S.J.C.R.

(B) P.M. 3-57, S.J.C.R.

LEGEND

-O- INDICATES FOUND CHISELED CROSS PER (A)(B), REPLACED AND SET

LEAD AND TACK W/TAG STAMPED LS 4450

+ INDICATES FOUND CHISELED CROSS PER (B)
P.M. INDICATES PARCEL MAP, BOOK AND PAGE, S.J.C.R.

R.S. NDICATES RECORD OF SURVEY, BOOK AND PAGE, S.J.C.R. DOC. NO. INDICATES DOCUMENT NUMBER, S.J.C.R.

DOC. NO. INDICATES DOCUMENT NUMBER, S.J.C.R. S.J.C.R. INDICATES SAN JOAQUIN COUNTY RECORDS S.F.N. INDICATES SEARCHED FOUND NOTHING