CORNER RECORD Agency Index Document Number City of City of Manteca County of San Joaquin Californi Brief Legal Description Chiseled crosses along the Westerly right-of-way line of Main Street as shown on R.S. 23-160, S.J.C.R. CORNER TYPE COORDINATES (Optional) Control					
City of Manteca County of San Joaquin , Californi Brief Legal Description Chiseled crosses along the Westerly right-of-way line of Main Street as shown on R.S. 23-160, S.J.C.R. CORNER TYPE COORDINATES (Optional)	COF	NED DEC	OPD	Agency Index	CR-19-49
Brief Legal Description Chiseled crosses along the Westerly right-of-way line of Main Street as shown on R.S. 23-160, S.J.C.R. CORNER TYPE COORDINATES (Optional) NE. Government Corner	COMMEN MECOND				
Brief Legal Description Chiseled crosses along the Westerly right-of-way line of Main Street as shown on R.S. 23-160, S.J.C.R. CORNER TYPE COORDINATES (Optional) NE. Government Corner	City of	City of Manteca	County of	San Joaqu	uin, California
Government Corner Control Elevation U.S. Survey Foot Horizontal Datum Zone Epoch Date Epoch Date Complies with Public Resources Code §§8801-8819 Complies with Public Resources Code §§8801-8819 Complies with Public Resources Code §§8890-8902 PLS Act Ref.: 8771 8773 Other: Corner/ Left as found Established Rebuilt Pre-Construction Pre-Construction Monument: Found and tagged Reestablished Referenced Post-Construction Post-Construction Narrative of corner identified and monument as found, set, reset, replaced, or removed: See sheet #2 for description(s):					
Government Corner Control Elevation U.S. Survey Foot Horizontal Datum Zone Epoch Date Epoch Date Complies with Public Resources Code §§8801-8819 Complies with Public Resources Code §§8801-8819 Complies with Public Resources Code §§8890-8902 PLS Act Ref.: 8771 8773 Other: Corner/ Left as found Established Rebuilt Pre-Construction Pre-Construction Monument: Found and tagged Reestablished Referenced Post-Construction Post-Construction Narrative of corner identified and monument as found, set, reset, replaced, or removed: See sheet #2 for description(s):		0000	ED TVDE	COORDIA	IATES (Ontional)
Government Corner		CORNER TYPE		, and a second s	
Rancho Other Horizontal Datum Zone Epoch Date Date of Survey January 5, 2019 Vertical Datum		Government Corner	Control		
Date of Survey Date of Survey January 5, 2019 Vertical Datum		Meander	Property X	Units Metric	U.S. Survey Foot X
Date of Survey January 5, 2019 Vertical Datum Sec. 29, T.1S., R.7E., Complies with Public Resources Code §§8890-8902 PLS Act Ref.: 8765(d) 8771 8773 Other: Corner/ Left as found Established Rebuilt Pre-Construction Monument: Found and tagged Reestablished Referenced Post-Construction Narrative of corner identified and monument as found, set, reset, replaced, or removed: See sheet #2 for description(s): Surveyor's STATEMENT This Corner Record was prepared by me or under my direction in conformance with the Professional Land Surveyors' Act on Manual Land Surveyors		Rancho	Other	Horizontal Datum	
Sec. 29, T.1S., R.7E., Complies with Public Resources Code §§8890-8902 PLS Act Ref.: 8765(d) 8771 8773 Other: Corner/ Monument: Found and tagged Reestablished Referenced Post-Construction Narrative of corner identified and monument as found, set, reset, replaced, or removed: See sheet #2 for description(s): SURVEYOR'S STATEMENT This Corner Record was prepared by me or under my direction in conformance with the Professional Land Surveyors' Act on 1 Man 23 M9			_		
Sec. 29, T.1S., R.7E., M.D.B. & M. PLS Act Ref.: 8765(d) 8771 8773 Other: Corner/ Monument: Left as found Established Rebuilt Pre-Construction Monument: Found and tagged Reestablished Referenced Post-Construction Narrative of corner identified and monument as found, set, reset, replaced, or removed: See sheet #2 for description(s): SURVEYOR'S STATEMENT This Corner Record was prepared by me or under my direction in conformance with the Professional Land Surveyors' Act on May 23 M9		Date of Survey	January 5, 2019		
PLS Act Ref.: S8765(d) 8771 8773 Other: Corner/ Monument: Found and tagged Reestablished Referenced Post-Construction Narrative of corner identified and monument as found, set, reset, replaced, or removed: See sheet #2 for description(s): SURVEYOR'S STATEMENT This Corner Record was prepared by me or under my direction in conformance with the Professional Land Surveyors' Act on May 23 2019	Sec. 29, T.1S., R	.7E.,			ARROWS
Corner/ Monument: Left as found Found and tagged Reestablished Referenced Post-Construction Narrative of corner identified and monument as found, set, reset, replaced, or removed: See sheet #2 for description(s): SURVEYOR'S STATEMENT This Corner Record was prepared by me or under my direction in conformance with the Professional Land Surveyors' Act on MM 23 W19 No. 4450	M.D.B. & M.			Compiles with Public R	esources Code 998890-8902
the Professional Land Surveyors' Act on		SURVEYOR'S STA	ATEMENT	M.	
the Professional Land Surveyors' Act on	This Comes December	use supposed by me or under n	nu direction in conforma	acc with	2/3
			/ 1	ale	10,4450
Signed L. Churtanli P.L.S. or R.C.E. No. L.S. 4450	the Professional Land	d Surveyors' Act on	Mary 68, 00		
	Signed	Quartarli	P.L.S. or R.C.E. No.	L.S. 4450	E OF CALFORN
		<i>Y</i>	- T _S		and the same of th

COUNTY SURVEYOR'S STATEMENT

This Corner Record was received

April 24, 2019

and examined and filed

May 7, 2019

Signed


P.L.S. or R.G.E. No. 8657

Title

County Surveyor


LICENSE No. 8657

County Surveyor's Comment

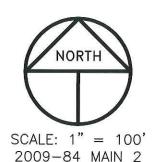

REFERENCE

(A) R.S. 23-160, S.J.C.R.

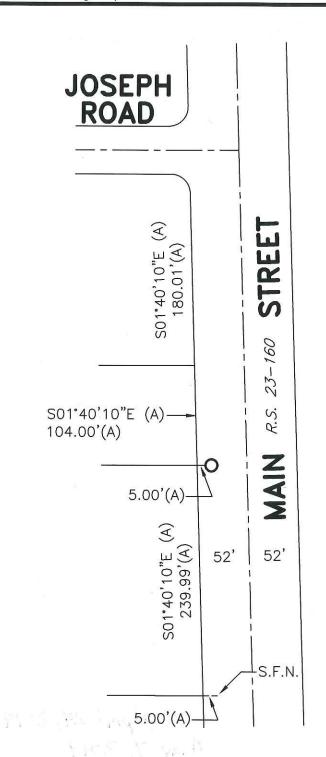

LEGEND

INDICATES FOUND CHISELED CROSS PER (A)(B), REPLACED AND SET

LEAD AND TACK W/TAG STAMPED LS 4450
P.M. INDICATES PARCEL MAP, BOOK AND PAGE, S.J.C.R.
R.S. INDICATES RECORD OF SURVEY, BOOK AND PAGE, S.J.C.R.
DOC. NO. INDICATES DOCUMENT NUMBER, S.J.C.R. S.J.C.R. INDICATES SAN JOAQUIN COUNTY RECORDS

S.F.N. INDICATES SEARCHED FOUND NOTHING