

CORNER RECORD


Agency Index CR-19-64

Document Number _____

City of STOCKTON

County of SAN JOAQUIN, California

Brief Legal Description REESTABLISHED MONUMENTS AROUND BLOCK 7 OF WEST OF CENTER STREET, 2-M&P-36, S.J.C.R.

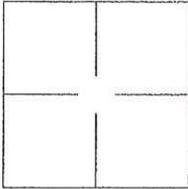

CORNER TYPE

Government Corner Control
 Meander Property
 Rancho Other

Date of Survey February 28th, 2019

COORDINATES (Optional)

N. _____ E. _____

Elevation _____

Units Metric U.S. Survey Foot

Horizontal Datum _____

Zone _____ Epoch Date _____

Vertical Datum: _____

Complies with Public Resources Code §§8801-8819

Complies with Public Resources Code §§8890-8902

PLS Act Ref.: 8765(d) 8771 8773

Other: _____

Corner/Monument: Left as found Established Rebuilt Pre-Construction
 Found and tagged Reestablished Referenced Post-Construction

Narrative of corner identified and monument as found, set, reset, replaced, or removed:

See sheet #2 for description(s):

SURVEYOR'S STATEMENT

This Corner Record was prepared by me or under my direction in conformance with

the Professional Land Surveyor's Act on April 24TH, 2019

Signed [Signature] P.L.S. or R.C.E. No.: 8366



COUNTY SURVEYOR'S STATEMENT


This Corner Record was received May 2, 2019 and examined and filed June 10, 2019

Signed James E. Hart P.L.S. or R.C.E. No.: 8657

Title County Surveyor

County Surveyor's Comment _____



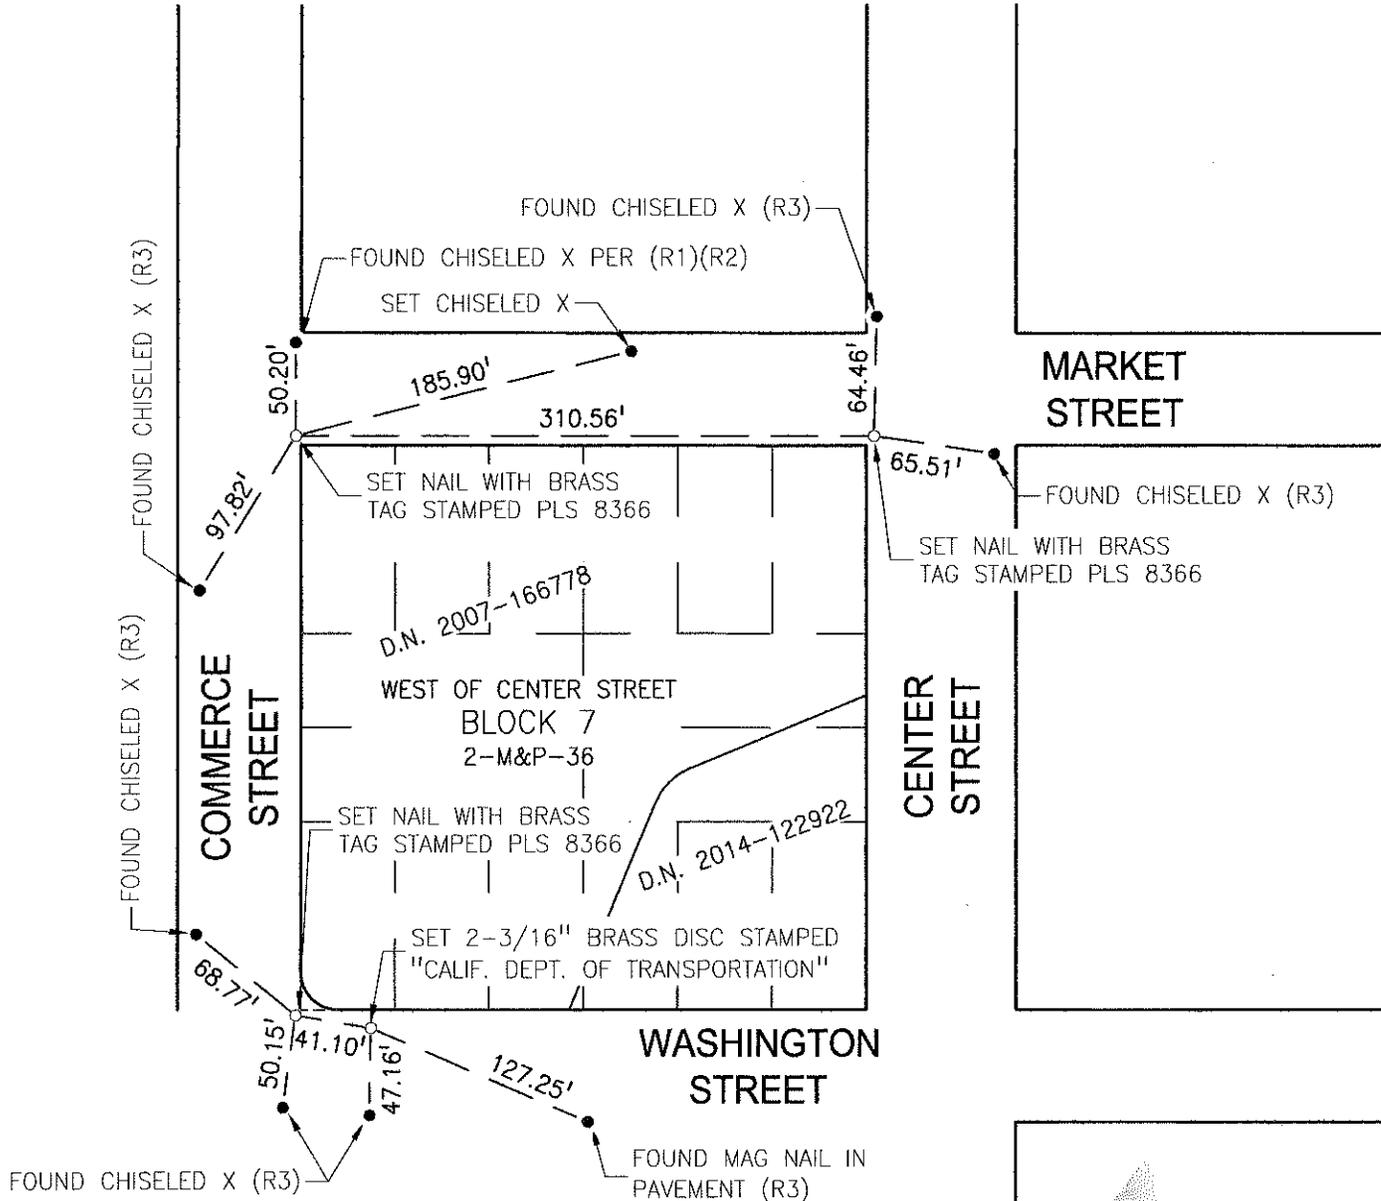

REFERENCES

- (R1) BOOK 10 OF PARCEL MAPS, PAGE 123, S.J.C.R.
- (R2) BOOK 27 OF SURVEYS, PAGE 186, S.J.C.R.
- (R3) CORNER RECORD CR-18-174, ON FILE WITH THE SAN JOAQUIN COUNTY SURVEYOR

