CORNER RECORD


Agency Index **Document Number** County of California San Joaquin Brief Legal Description Westerly right-of-way line of Maybeck Road per R.S. 39-82, S.J.C.R. **CORNER TYPE** COORDINATES (Optional) X Control Government Corner Elevation U.S. Survey Foot Meander Property Units Metric Rancho Other Horizontal Datum Epoch Date Date of Survey May 21, 2019 Vertical Datum Complies with Public Resources Code §§8801-8819 Sec. 24, T.1N., R.5E., M.D.B. & M. Complies with Public Resources Code §§8890-8902 PLS Act Ref.: 8765(d) 8771 8773 Other: Left as found Established Rebuilt Pre-Construction Corner/ Monument: Found and tagged Post-Construction Reestablished Referenced Narrative of corner identified and monument as found, set, reset, replaced, or removed: ✓ See sheet #2 for description(s): SURVEYOR'S STATEMENT This Corner Record was prepared by me or under my direction in conformance with the Professional Land Surveyors Act on **COUNTY SURVEYOR'S STATEMENT** June 11, 2019 June 25, 2019 E. Had P.L.S. OFRICE. No. 8657 This Corner Record was received and examined and filed Signed Title

(D.D. Sheet No. 95) BPELSG-2016

County Surveyor's Comment

Page 1 of 2

Job No.: 2019-63

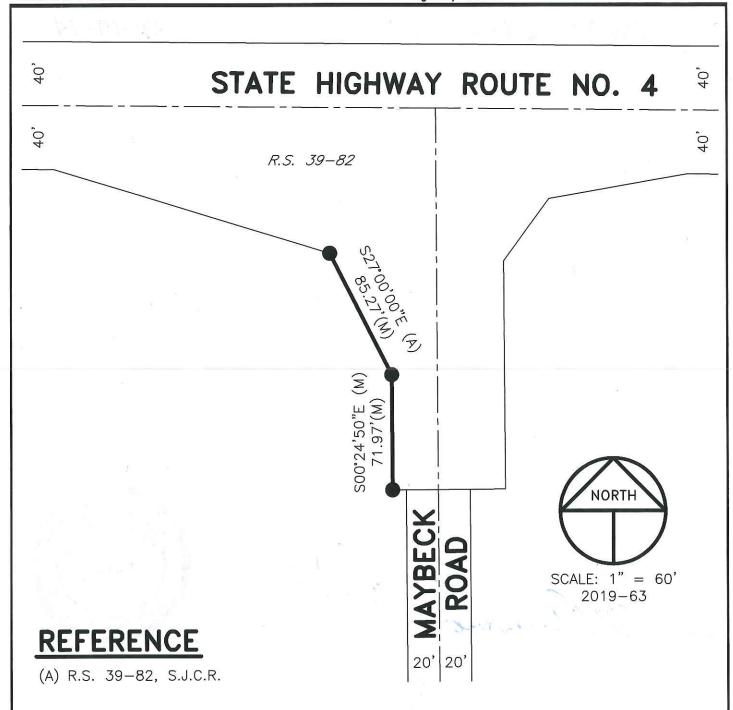



INDICATES FOUND 1" IRON PIPE W/ALUMINUM CAP STAMPED "DOT", NO RECORD, NO REFERENCE, CALLED W/PLASTIC CAP PER (A)

105 2 sect

R.S. A INDICATES RECORD OF SURVEY, BOOK AND PAGE, S.J.C.R.

S.J.C.R. INDICATES SAN JOAQUIN COUNTY RECORDS