Agency Index CORNER RECORD **Document Number** County of California San Joaquin City of Brief Legal Description Southerly line of Parcel "3" per P.M. 25-35, S.J.C.R. **COORDINATES (Optional) CORNER TYPE** Government Corner Control Elevation U.S. Survey Foot Metric Property Units Meander Rancho Other Horizontal Datum Epoch Date Date of Survey May 21, 2019 Vertical Datum Complies with Public Resources Code §§8801-8819 Sec. 16 & 17, T.1S., R.6E., Complies with Public Resources Code §§8890-8902 M.D.B. & M. X 8765(d) 8771 8773 Other: PLS Act Ref.: Pre-Construction Left as found Established Rebuilt Corner/ Monument: Post-Construction Found and tagged Reestablished Referenced Narrative of corner identified and monument as found, set, reset, replaced, or removed: ✓ See sheet #2 for description(s): SURVEYOR'S STATEMENT This Corner Record was prepared by me or under my direction in conformance with the Professional Land Surveyors' Act on



This Corner Record was received June 11, 2019


and examined and filed June 25, 2019

Signed F. Hart P.L.S. or R.C.E. No. 8657

Title County Surveyor

County Surveyor




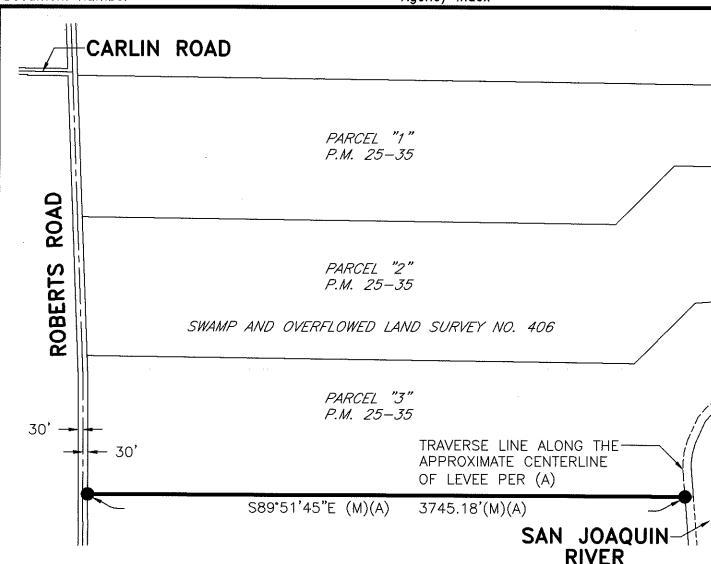

REFERENCE

(A) P.M. 25-35, S.J.C.R.



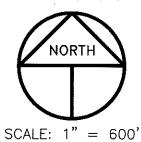

SCALE: 1 = 600° . 2019-109

INDICATES FOUND 3/4" IRON PIPE W/TAG STAMPED LS 4450 PER (A), SET PLASTIC CAP STAMPED LS 4450

P.M. INDICATES PARCEL MAP, BOOK AND PAGE, S.J.C.R.

S.J.C.R. INDICATES SAN JOAQUIN COUNTY RECORDS