


CORNER RECORD

Agency Index CR-19-76
Document Number _____

City of _____ County of San Joaquin, California
Brief Legal Description S.E. Cor. of Parcel "F" per R.S. 24-116, S.J.C.R.

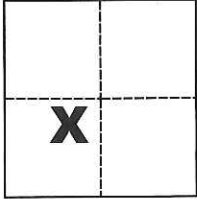

CORNER TYPE

Government Corner Control
Meander Property
Rancho Other

Date of Survey May 28, 2019

COORDINATES (Optional)

N. _____ E. _____
Elevation _____
Units Metric U.S. Survey Foot
Horizontal Datum _____
Zone _____ Epoch Date _____
Vertical Datum _____

Complies with Public Resources Code §§8801-8819
 Complies with Public Resources Code §§8890-8902

Section 15, T.2N., R.8E.,
M.D.B. & M.

PLS Act Ref.: 8765(d) 8771 8773 Other:
Corner/Monument: Left as found Established Rebuilt Pre-Construction
 Found and tagged Reestablished Referenced Post-Construction

Narrative of corner identified and monument as found, set, reset, replaced, or removed:
 See sheet #2 for description(s):

SURVEYOR'S STATEMENT

This Corner Record was prepared by me or under my direction in conformance with
the Professional Land Surveyors' Act on May 29, 2019
Signed Michael L. Quarantoni P.L.S. or R.C.E. No. L.S. 4450



COUNTY SURVEYOR'S STATEMENT

This Corner Record was received June 11, 2019
and examined and filed June 25, 2019
Signed James E. Hart P.L.S. or R.C.E. No. 8657
Title County Surveyor



County Surveyor's Comment


DOC. NO. 2013-133548

DOC. NO. 2016-149496

PARCEL "F"
R.S. 24-116


R.S. 19-101

FD. 3/4" IRON PIPE PER (A)(B),
NOT TAGGED, 6" DEEP, SET
PLASTIC CAP STAMPED LS 4450
PER (C)

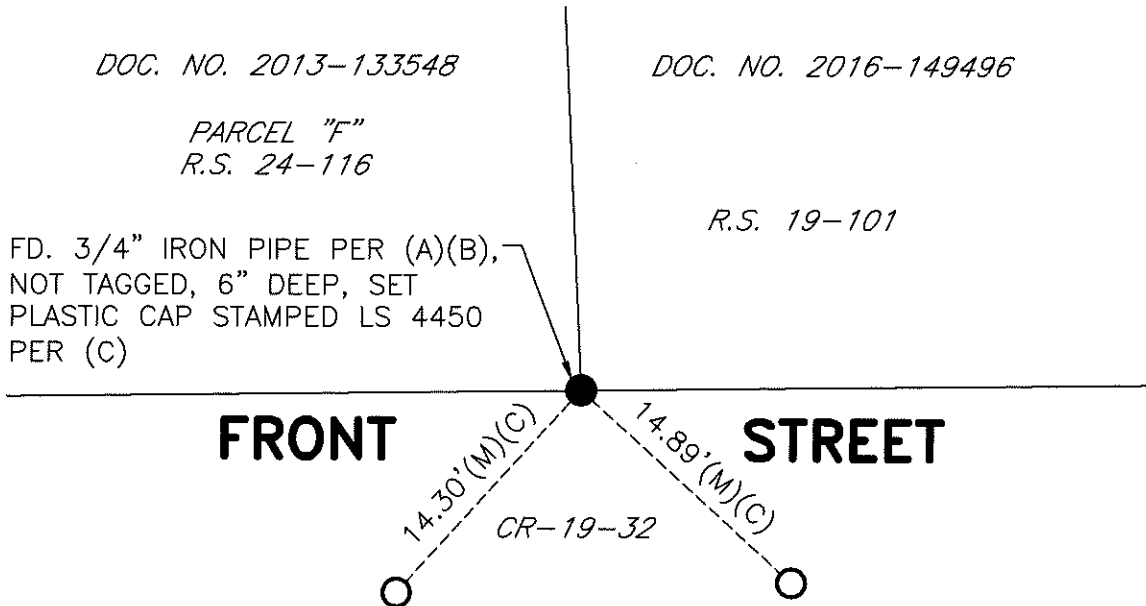

REFERENCES

- (A) R.S. 19-101, S.J.C.R.
- (B) R.S. 24-116, S.J.C.R.
- (C) CR-19-32, S.J.C.S.R.

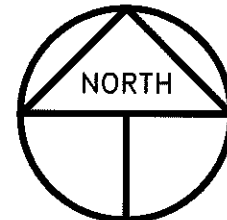

SCALE: 1" = 10'
2019-34 - POST

LEGEND

- INDICATES FOUND MONUMENT AS NOTED
- INDICATES FOUND CONCRETE NAIL W/TAG STAMPED LS 4450 PER (C)
- R.S. INDICATES RECORD OF SURVEY, BOOK AND PAGE, S.J.C.R.
- DOC. NO. INDICATES DOCUMENT NUMBER, S.J.C.R.
- CR INDICATES CORNER RECORD, S.J.C.S.R.
- S.J.C.R. INDICATES SAN JOAQUIN COUNTY RECORDS
- S.J.C.S.R. INDICATES SAN JOAQUIN COUNTY SURVEYOR'S RECORDS
- (M) INDICATES MEASURED ON THIS SURVEY