
## CORNER RECORD

Agency Index \_\_CR-19-82 Document Number \_\_\_\_\_ County of SAN JOAQUIN , California City of STOCKTON Brief Legal Description MONUMENT AT SOUTHEAST CORNER OF PARCEL 1, PER 26-PM-76 COORDINATES (Optional) **CORNER TYPE** Control Government Corner Metric U.S. Survey Foot Units Meander Property -SEC. 28-Horizontal Datum \_\_\_ Other Zone \_\_\_\_\_ Epoch Date \_\_\_ Vertical Datum: \_\_\_\_ Date of Survey 2019-04-19 T1N/R7E Complies with Public Resources Code §§8801-8819 Complies with Public Resources Code §§8890-8902 8765(d) PLS Act Ref .: X 8771 8773 Other: Rebuilt Pre-Construction Corner/ Left as found Established Post-Construction Referenced Monument: Found and tagged Reestablished Narrative of corner identified and monument as found, set, reset, replaced, or removed: See sheet #2 for description(s): SURVEYOR'S STATEMENT This Corner Record was prepared by me or under my direction in conformance with the Professional Land Surveyor's Act on No. 8366 P.L.S. or R.C.E. No.: 8366 Signed Exp. 12-31-2019COUNTY SURVEYOR'S STATEMENT June 28 2019 and examined This Corner Record was received James Z Hart P.L.S. OF R.C.E. No.: 8657 County Surveyor County Surveyor's Comment

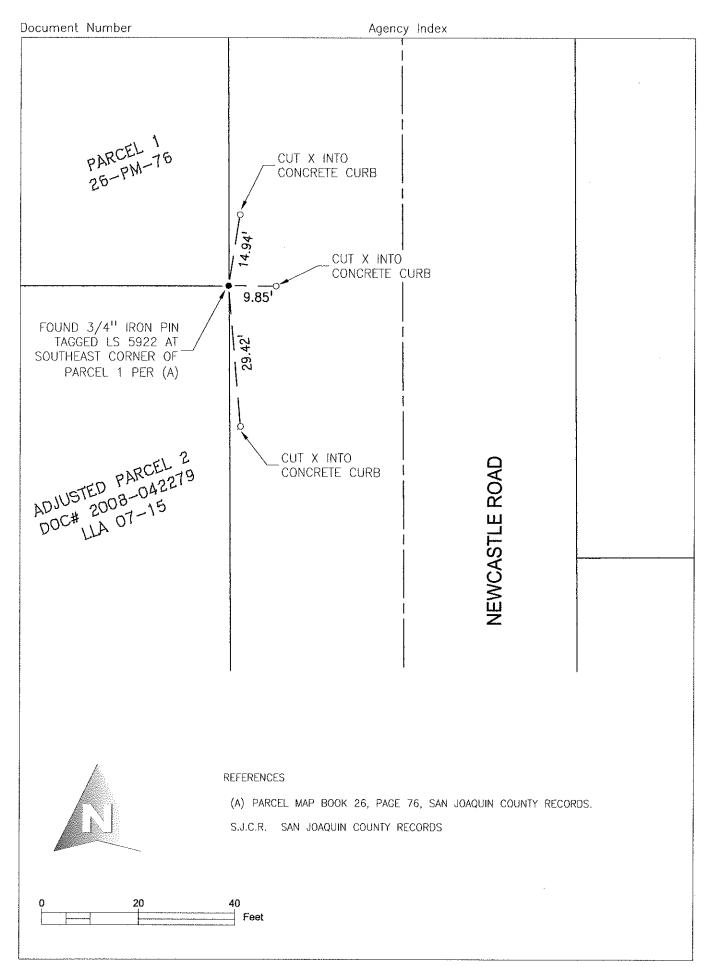

Page 2 of 2