

CORNER RECORD

Agency Index: CR-19-93
Document Number: _____

City of LATHROP County of SAN JOAQUIN, California

Brief Legal Description FOUND MONUMENT ON THE CENTERLINE OF HARLAN ROAD APPROXIMATELY 91.5'+/- SOUTH OF THE CENTERLINE OF LATHROP ROAD LOCATED IN SECTION 26. T.1S, R.6E M.D.B.&M.



T.1S, R.6E

CORNER TYPE

- Government Corner
- Meander
- Rancho
- Control
- Property
- Other

Date of Survey 7-16-2019

COORDINATES (Optional)

N. _____ E. _____
 Elevation _____
 Units Metric U.S. Survey Foot
 Horizontal Datum _____
 Zone _____ Epoch Date _____
 Vertical Datum _____
 Complies with Public Resources Code SS8801-8819
 Complies with Public Resources Code SS8890-8902

PLS Act Ref: 8765(d) 8771 8773 Other: _____

Corner/
 Monument: Left as found Established Rebuilt Pre-Construction
 Found and Tagged Reestablished Referenced Post-Construction

Narrative of corner identified and monument as found, set, reset, replaced, or removed:

See sheet #2 for description(s):

FOUND 2-1/2" BRASS DISK STAMPED "LS 6953" IN MONUMENT WELL ON THE CENTERLINE OF HARLAN ROAD APPROXIMATELY 91.5'+/- SOUTH OF THE CENTERLINE OF LATHROP ROAD AS SHOWN ON BOOK 36 OF SURVEYS AT PAGE 9, SAN JOAQUIN COUNTY RECORDS. SET THREE (3) NAILS WITH BRASS TAGS STAMPED "LS 6953", ALL AS SHOWN ON PAGE 2.

SURVEYOR'S STATEMENT

This Corner Record was prepared by me or under my direction in conformance with the Land Surveyors' Act on JULY 19, 2019,

Signed [Signature] P.L.S. or R.C.E. Number 6953



COUNTY SURVEYOR'S STATEMENT

This Corner Record was received July 23, 2019

and examined and filed August 16, 2019


Signed James E. Hart P.L.S. or R.C.E. No. 8657

Title County Surveyor



County Surveyor's Comment _____

LATHROP ROAD

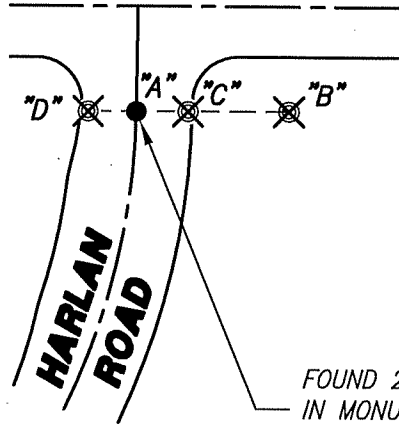

NOT TO SCALE

25-M&P-82
S.J.C.R.

FOUND 2-1/2" BRASS DISK
IN MONUMENT WELL,
STAMPED "LS 6953".(R1)

X AND DISTANCE TABLE		
BS-@-FS	X	FS DISTANCE
B-A-B	00°00'00"	131.93'(M)
B-A-C	00°00'00"	44.62'(M)
B-A-D	180°00'00"	42.17'(M)

REFERENCE:

(R1) 36-S-09, S.J.C.R.

LEGEND:

- ⊗ SET CONCRETE NAIL WITH BRASS TAG
L.S. 6953.
- FOUND MONUMENT AS NOTED.
- M&P- MAPS & PLATS
- S- RECORD OF SURVEY
- S.J.C.R. SAN JOAQUIN COUNTY RECORDS
- (M) MEASURED DISTANCE. ALL DISTANCES ARE
MEASURED UNLESS NOTED OTHERWISE.

NOTE:

THIS CORNER RECORD DOES NOT
VERIFY THIS MONUMENT TO BE
IN THE CORRECT POSITION.