

CORNER RECORD


Agency Index: CR-19-101

Document Number: _____

City of LATHROP

County of SAN JOAQUIN, California

Brief Legal Description MONUMENT APPROX 348.5FT WEST OF THE INTERSECTION OF LATHROP RD AND 5TH STREET. LOCATED IN THE NORTHEAST QUARTER OF SECTION 26. T.1S, R.6E M.D.B.&M.

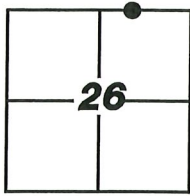

T.1S, R.6E

CORNER TYPE

- Government Corner Control
 Meander Property
 Rancho Other

Date of Survey 7-16-2019

COORDINATES (Optional)

N. _____ E. _____

Elevation _____

Units Metric U.S. Survey Foot

Horizontal Datum _____

Zone _____ Epoch Date _____

Vertical Datum _____

Complies with Public Resources Code SS8801-8819

Complies with Public Resources Code SS8890-8902

PLS Act Ref: 8765(d) 8771 8773 Other:

Corner/
 Monument: Left as found Established Rebuilt Pre-Construction
 Found and Tagged Reestablished Referenced Post-Construction

Narrative of corner identified and monument as found, set, reset, replaced, or removed:

See sheet #2 for description(s):

FOUND 2-1/2" BRASS DISK STAMPED "LS 8154" WAS REMOVED DURING CONSTRUCTION AND REPLACED WITH A 3/4" IRON PIPE TAGGED "LS 6953", ALL AS SHOWN ON PAGE 2.

SURVEYOR'S STATEMENT

This Corner Record was prepared by me or under my direction in conformance with the Land Surveyors' Act on AUGUST 20, 2019,

Signed [Signature] P.L.S. or R.C.E. Number 6953



COUNTY SURVEYOR'S STATEMENT

This Corner Record was received August 21, 2019


and examined and filed September 4, 2019

Signed [Signature] P.L.S. or R.C.E. No: 8657

Title County Surveyor



County Surveyor's Comment _____

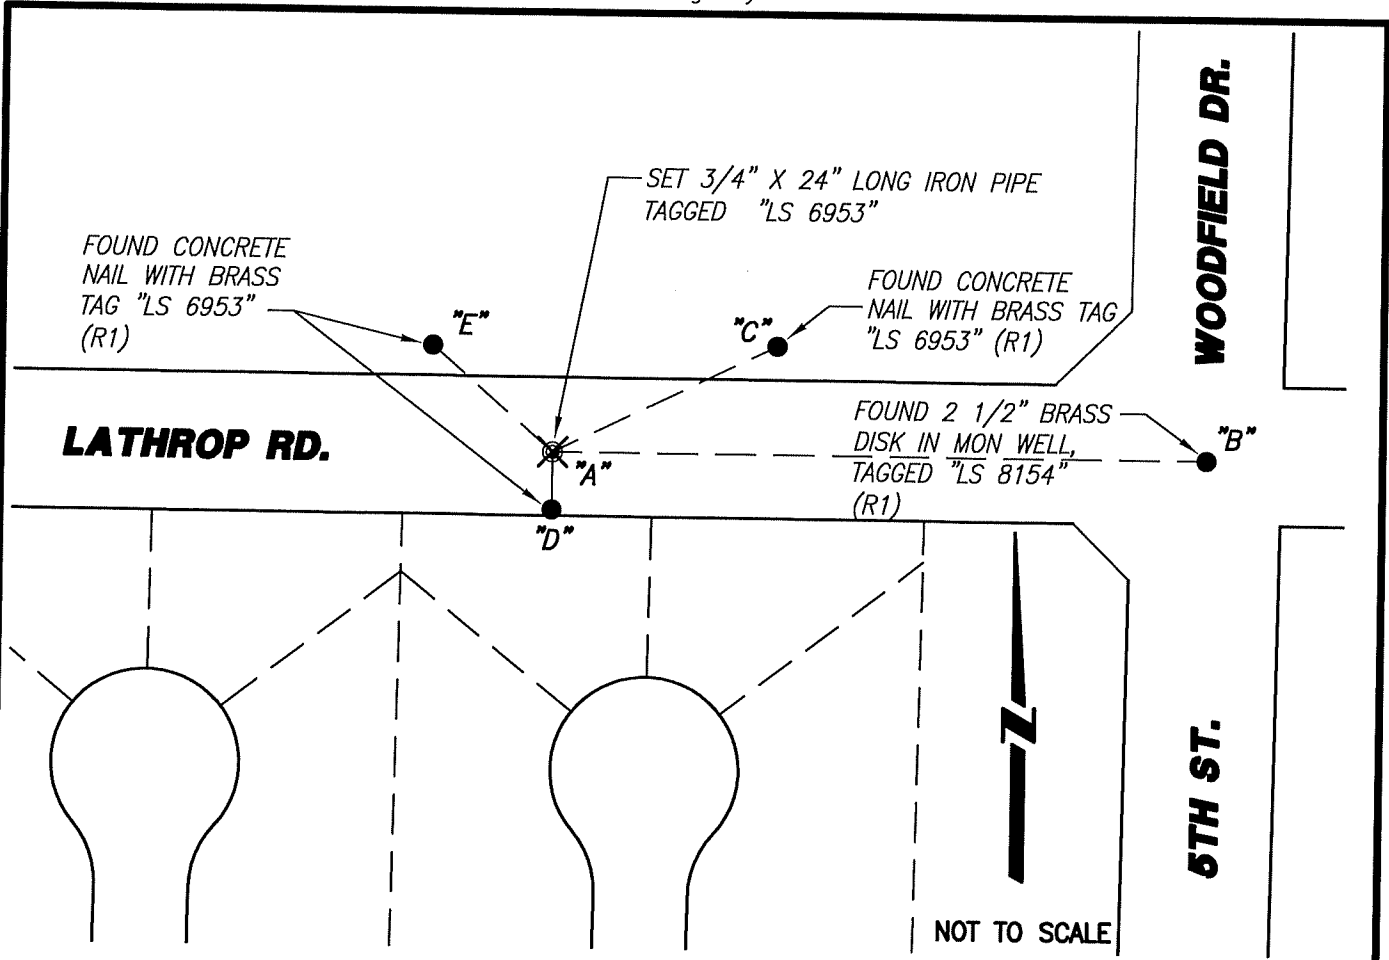

REFERENCE:

(R1) CORNER RECORD CR-17-334, S.J.C.S.R.

BS-@-FS	∠	FS DISTANCE
B-A-B	00°00'00"	348.490'(M)(R1)
B-A-E	221°24'15"	85.820'(M)(R1)
B-A-C	334°03'41"	131.915'(M)(R1)
B-A-D	90°00'00"	30.745'(M)(R1)

NOTE:

THIS CORNER RECORD DOES NOT VERIFY THIS MONUMENT TO BE IN THE CORRECT POSITION.

LEGEND:

- ⊗ SET MONUMENT AS NOTED
- FOUND MONUMENT AS NOTED.
- S.J.C.R. SAN JOAQUIN COUNTY RECORDS
- S.J.C.S.R. SAN JOAQUIN COUNTY SURVEYORS RECORDS
- (M) MEASURED DISTANCE. ALL DISTANCES ARE MEASURED UNLESS NOTED OTHERWISE.